


T.2S. R.39E. W.M.

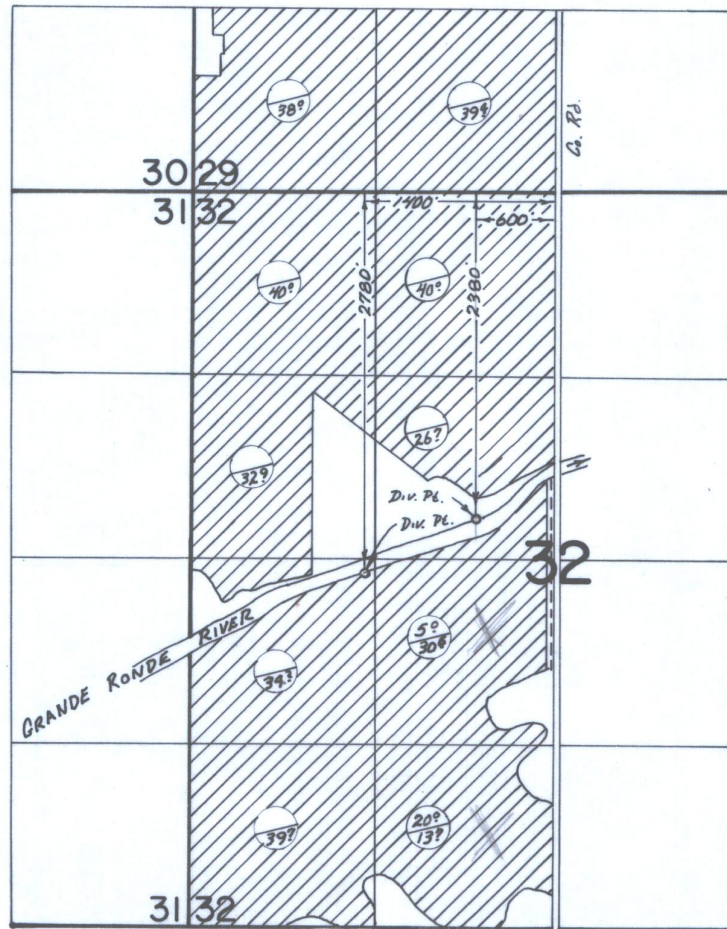

FINAL PROOF SURVEY
UNDER

Application No. 38208 Permit No. 28560

IN NAME OF

FRED KNAPE

Surveyed JULY 19, 1973, by R. B. MUCKEN