


T.4S, R.39 & 40E., W.M.

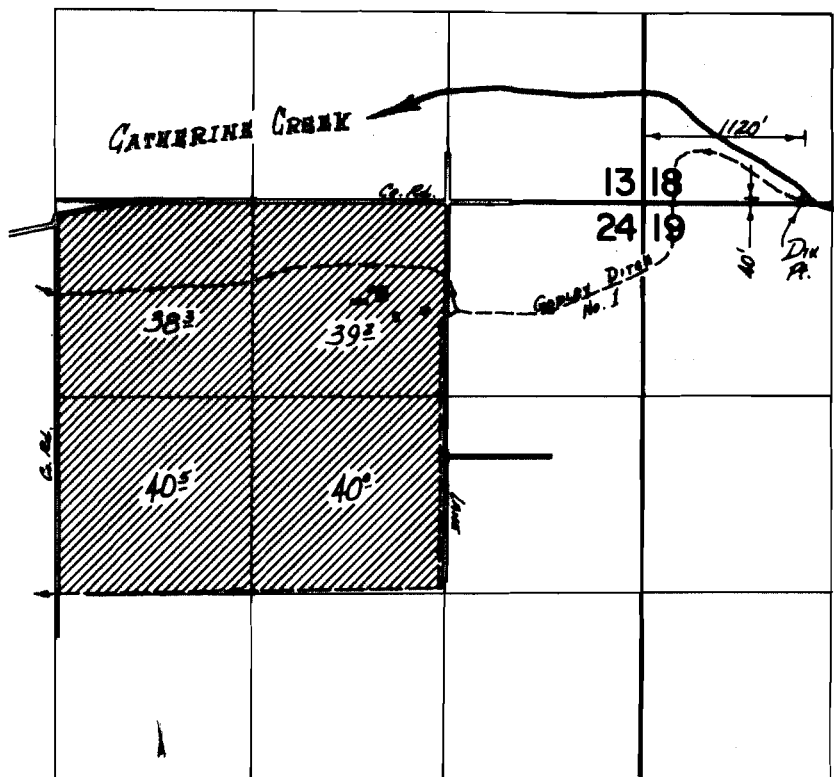

**FINAL PROOF SURVEY**  
UNDER

Application No. 40831 Permit No. 30419  
IN NAME OF

EASTERN OREGON EXPERIMENT STATION

Surveyed July 12 1973, by D. NORBY