


T.1S. R.39E. W.M.

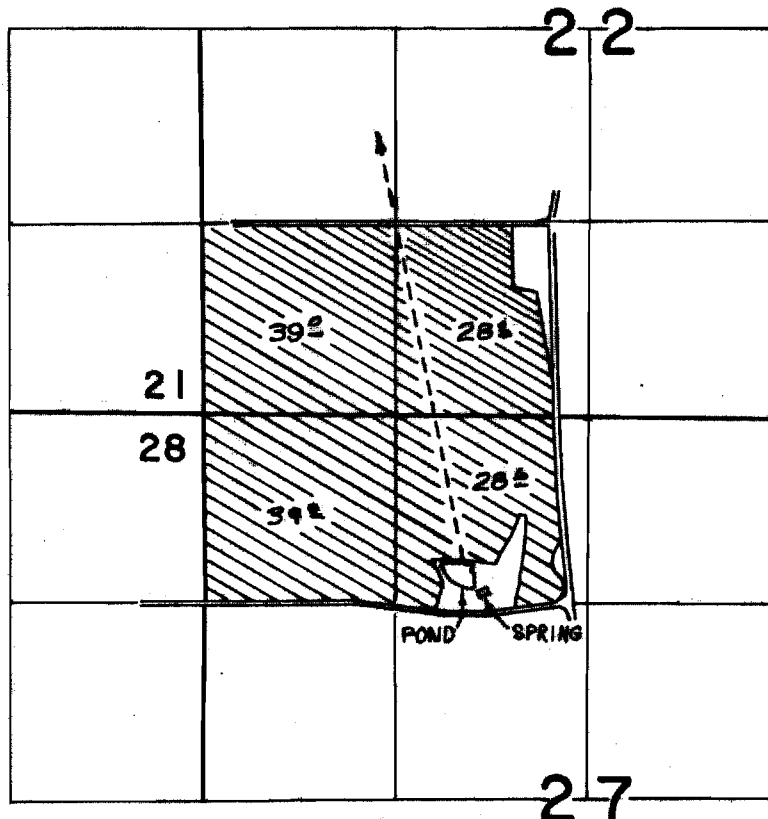

SPRING 75' N. 1925' E FROM SW COR. NW 1/4, NW 1/4 SEC. 27

FINAL PROOF SURVEY
UNDER

Application No. 42108 Permit No. 31535
IN NAME OF

ESTATE of FREDERICK C. HUNT

Surveyed July 19 1973, by R. MUCKEN