


T.2S. 39E. W.M.

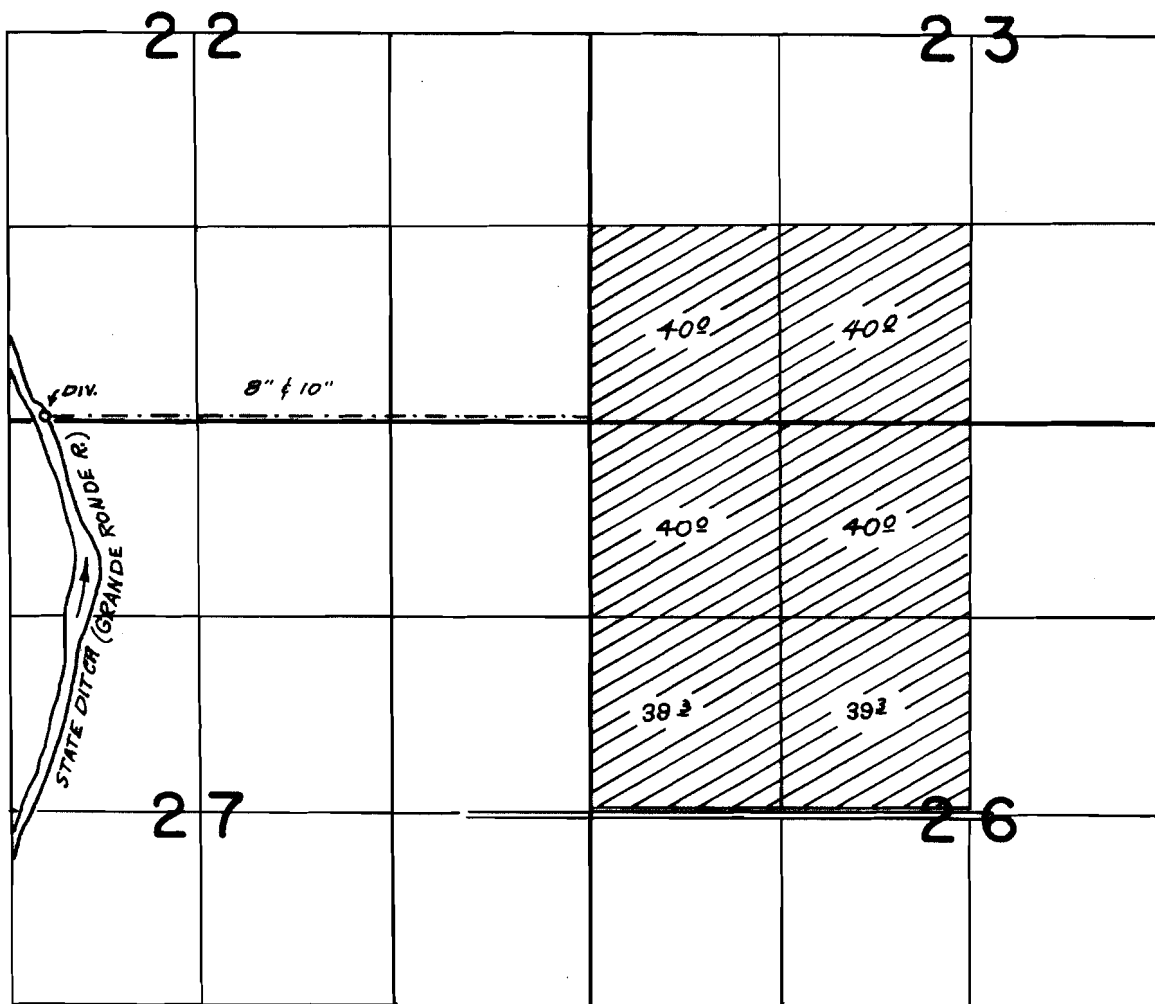

DIV. - 2700' N, 3725' W, FROM W. 1/4 CORNER SECTION 26

FINAL PROOF SURVEY
UNDER

Application No. 42196 Permit No. 31567
IN NAME OF

LILLIE B. MILLER & ESTATE OF WILLIAM D. MILLER

Surveyed July 18 1973, by R. MUCKEN