


T.1S. R.38E. W.M.

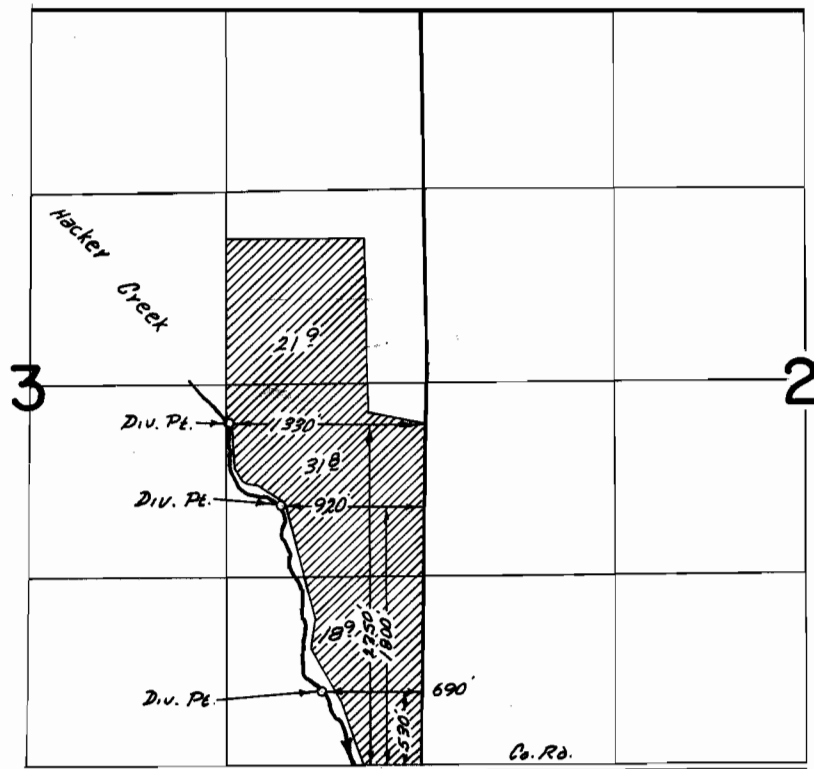

FINAL PROOF SURVEY
UNDER

Application No. 42322 Permit No. 31641
IN NAME OF

HAZEL N. CLARK & ESTATE OF CARL C. CLARK

Surveyed July 13 1973, by R.G. Mucken