


T. 1 S. R. 39 E. W. M.

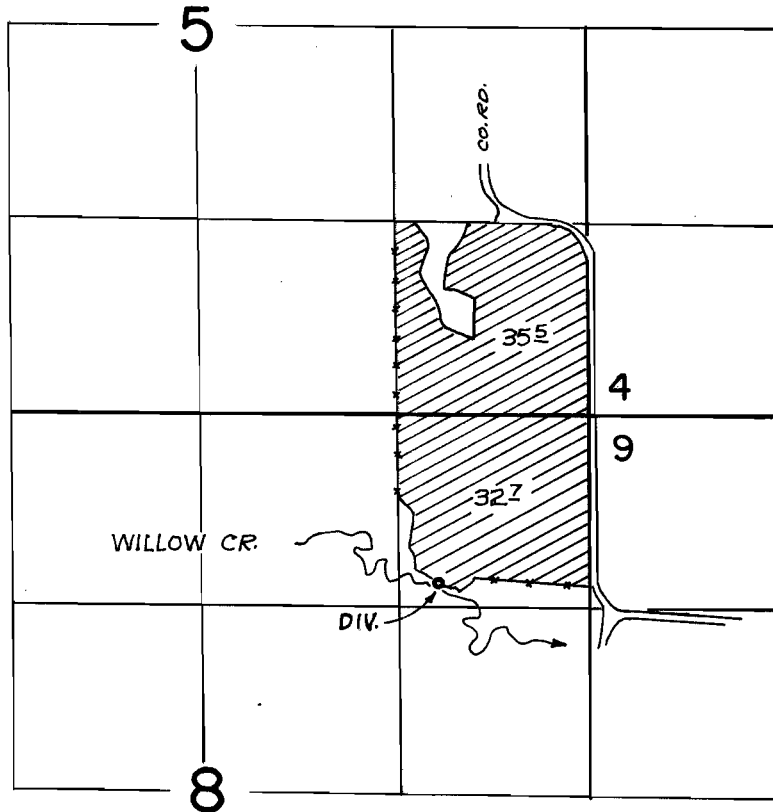

DIV. PT. 1450'N, 1600'E FROM CENTER SECTION 8

FINAL PROOF SURVEY
UNDER

Application No. 42905 Permit No. 32062
IN NAME OF

REED TAYLOR

Surveyed July 14 1973, by R. MUCKEN