


T.182S. R.39E. W.M.

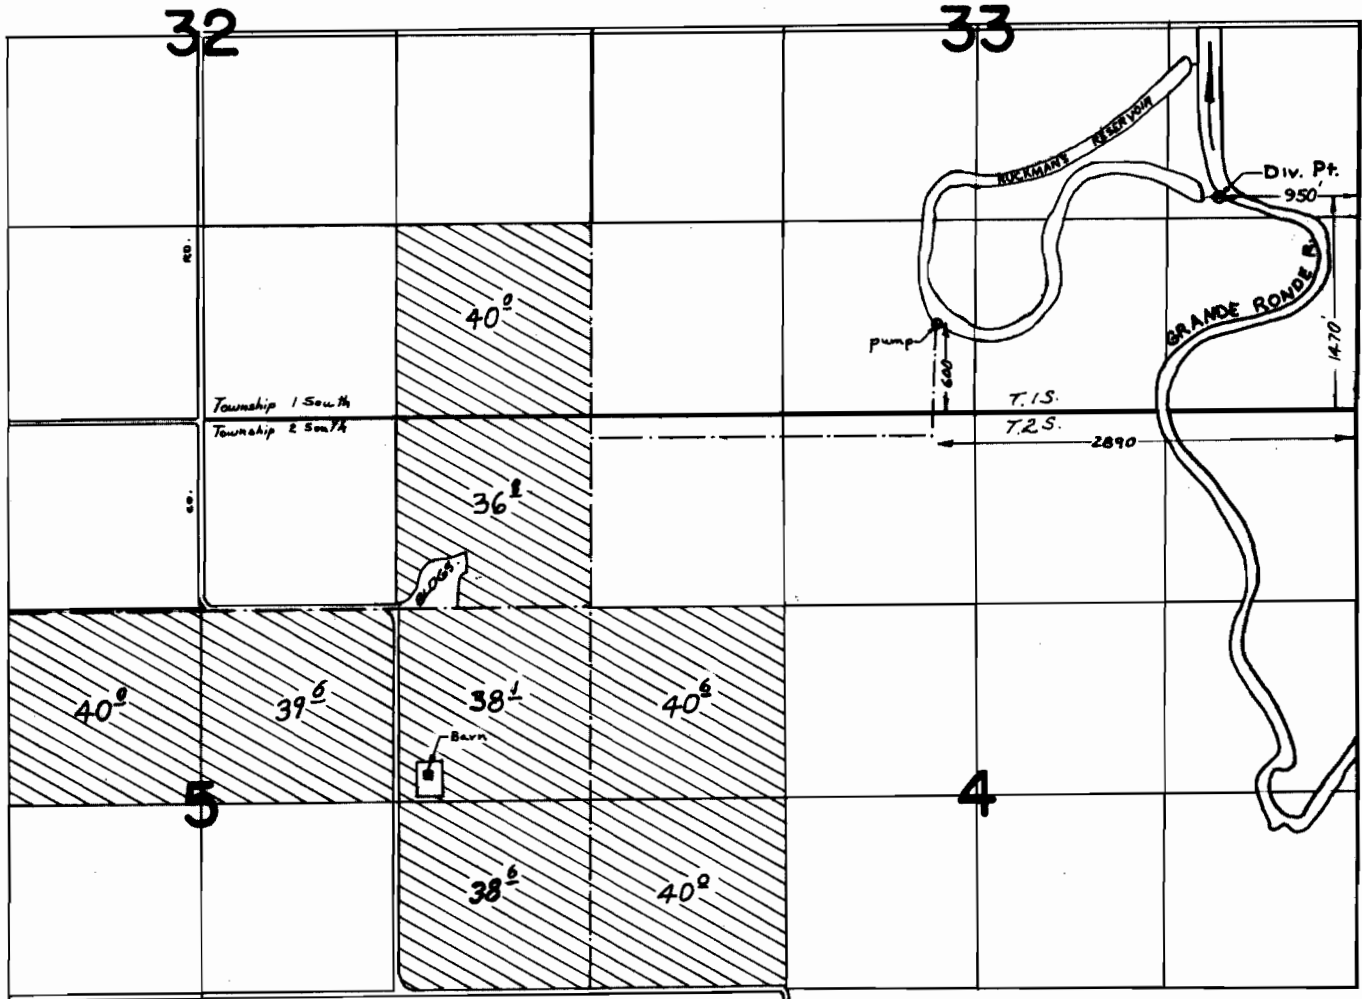

FINAL PROOF SURVEY
UNDER

Application No. 43147 Permit No. 32231
IN NAME OF

GAIL TALBOT

Surveyed JULY 16, 1973, by R.G. MUCKEN