


T.1S. R38E. W.M.

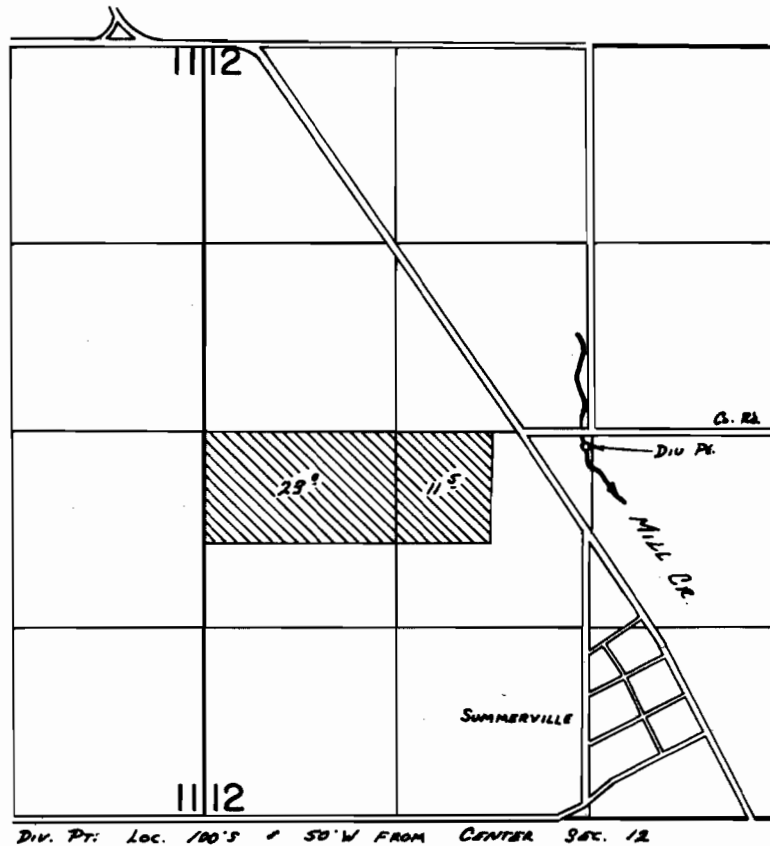

FINAL PROOF SURVEY
UNDER

Application No. 49241 Permit No. 92929
IN NAME OF

HARRY BILLERBECK

Surveyed July 10 1977, by R. G. MUCKEN