



T.3S.,R.40E.,W.M.

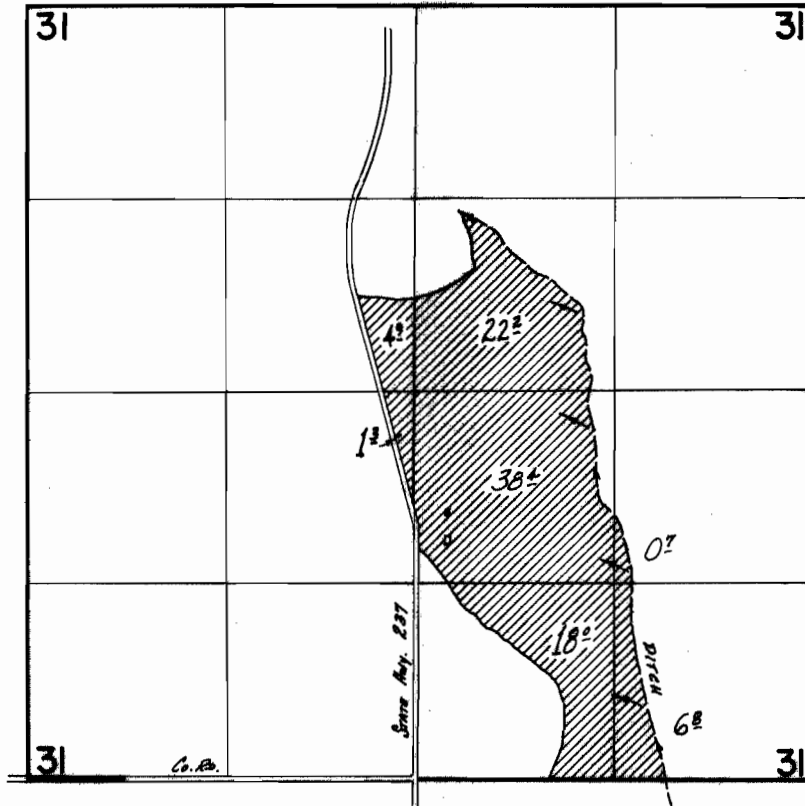

T.4S.,R.40E.,W.M.

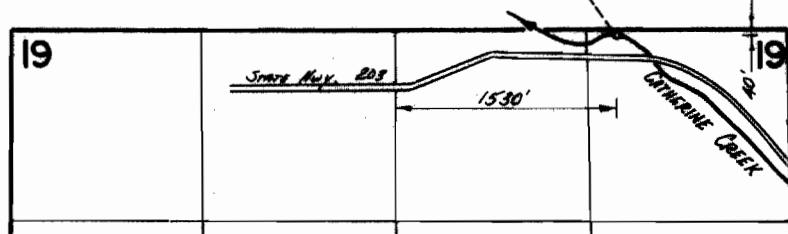

FINAL PROOF SURVEY
UNDER

Application No. 43614 Permit No. 32612
IN NAME OF

ROBERT WITHYCOMBE

Surveyed July 13 1973, by D. NORRIS