


# T.1S. R.38E. W.M.

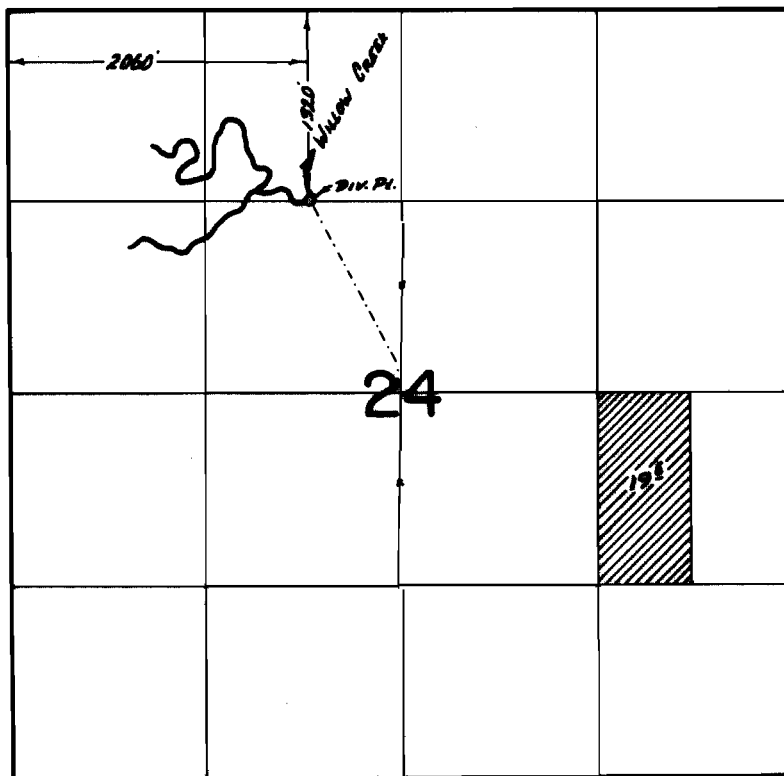

## FINAL PROOF SURVEY UNDER

Application No. 45227 Permit No. 34197  
IN NAME OF

DARRELL & GLENDA BILLERBECK & JOYCE & JIM BROWN

Surveyed July 10 1973, by R. G. MUCKEN