


# T.1S. R.39E. W.M.

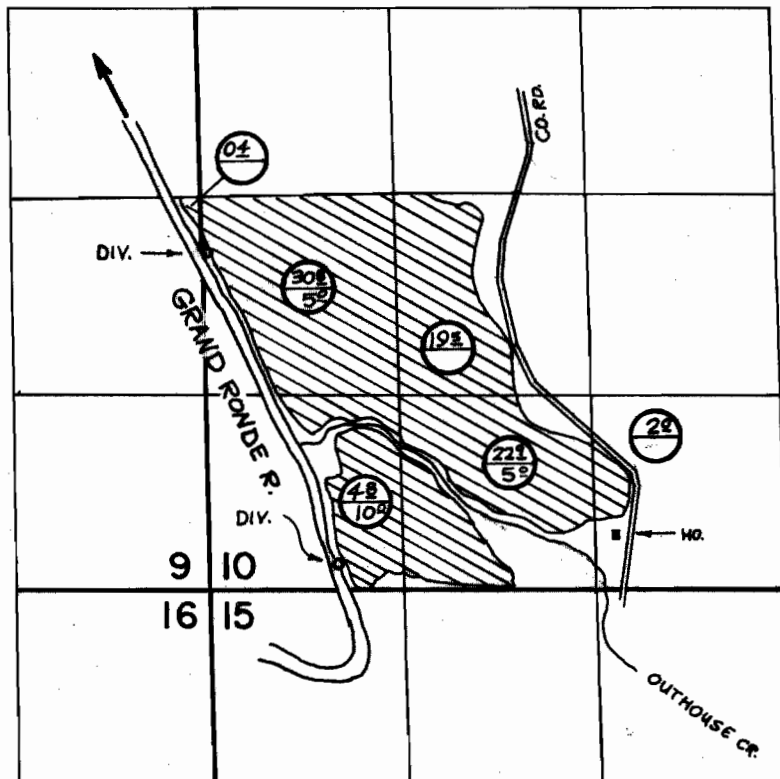

DIV. PTS. 2320' N & 40' E; 150' N & 875' E BOTH FROM S.W. CORNER SECTION 10

⊖ PRIMARY  
○ SUPPLEMENTAL

## FINAL PROOF SURVEY UNDER

Application No. 47829 Permit No. 35852  
IN NAME OF

TOMMY & DAVID NOYES

Surveyed July 19 1973, by R. MUCKEN

4" = 1 mile

CRK  
AIH-1MM-95