


T.1S. R.38E. W.M.

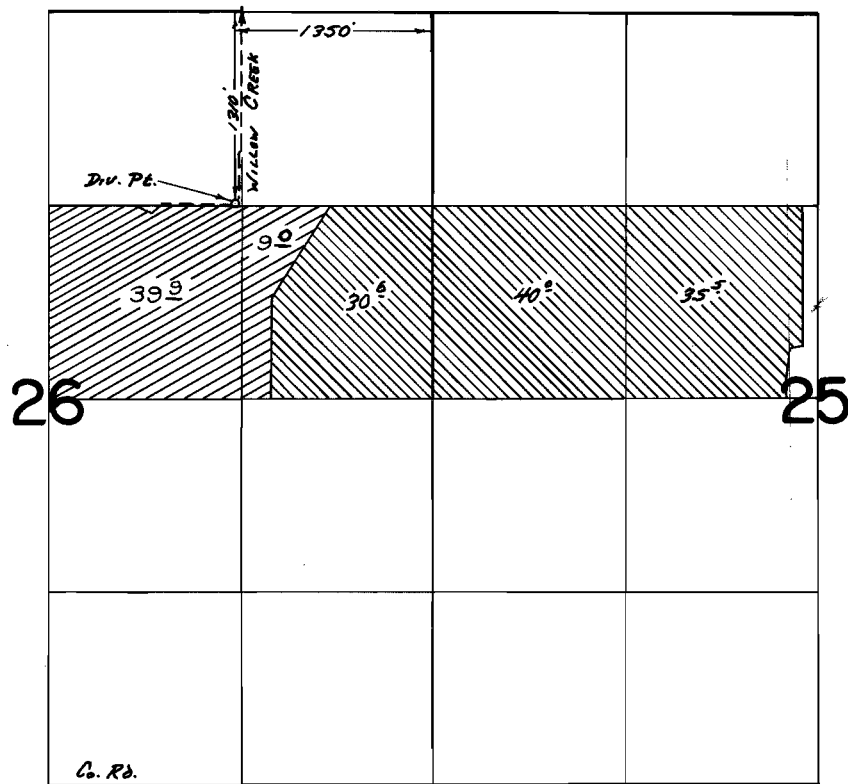

 47878
 50726

FINAL PROOF SURVEY
UNDER

Application No. 50726 47878 Permit No. 38314 35879
IN NAME OF

WILLIAM F. HOWELL

Surveyed July 11, 1973 by R.G. MUCKEN
Oct. 21, 1976, L.H. NUNN

PTS-1976-Q 
A1H-1MM-214 TP