


T.1S. R.39E. W.M.

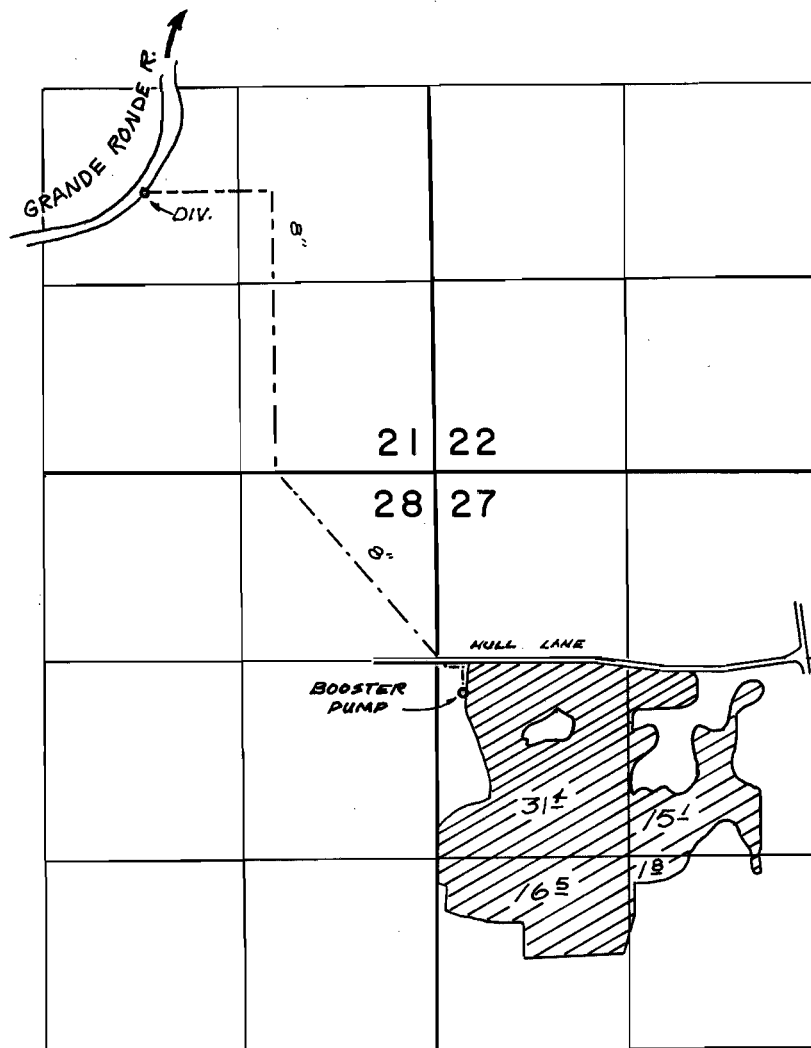

DIV. PT - 725' S, 690' E FROM CENTER SECTION 21

**FINAL PROOF SURVEY**  
UNDER

Application No. 47927 Permit No. 35903  
IN NAME OF

J. L. WESTENSKOW

Surveyed July 19 1973, by R. MUCKEN

CRK  
AIH-IMM-92  
AIH-IMM-142