


T.2S.,R.44E.,W.M.

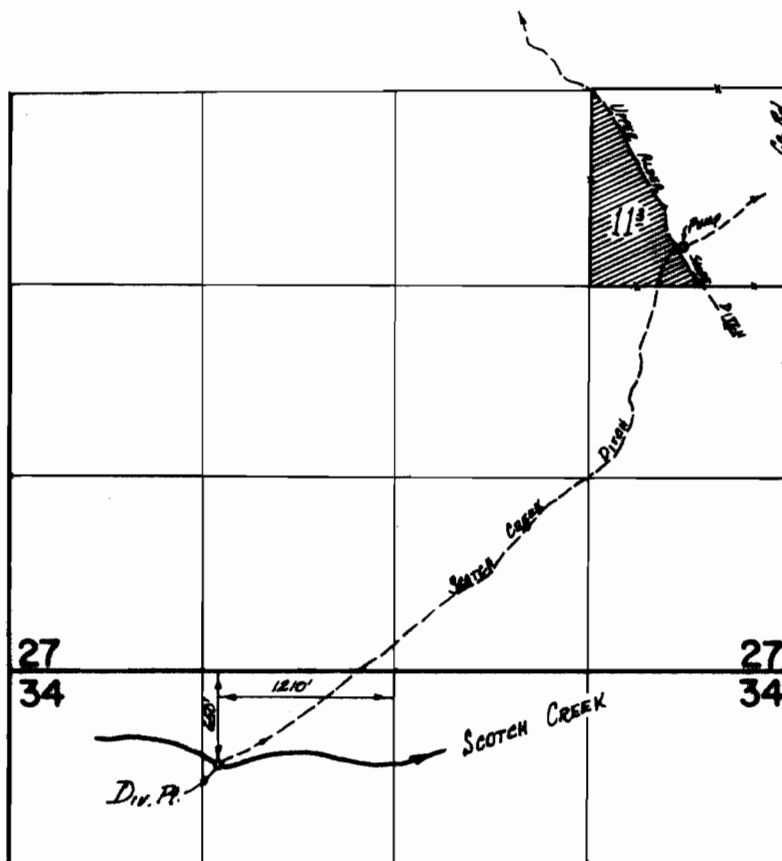

**FINAL PROOF SURVEY**  
UNDER

Application No. 42778 Permit No. 31982  
IN NAME OF

C. R. RUSSELL

Surveyed Aug. 7 1973, by D. Norby