


T.2S,R.44E.,W.M.

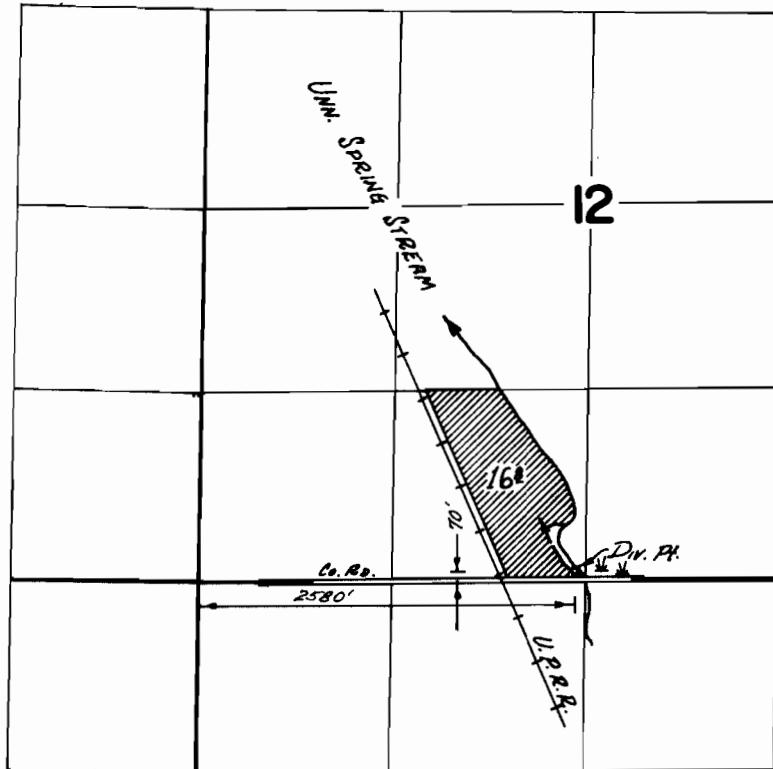

**FINAL PROOF SURVEY**  
UNDER

Application No. 44373 Permit No. 33147  
IN NAME OF

ORVILLE MAKIN

Surveyed Aug. 7 19 73, by D. Noreby