


T.1S.,R.43E.,W.M.

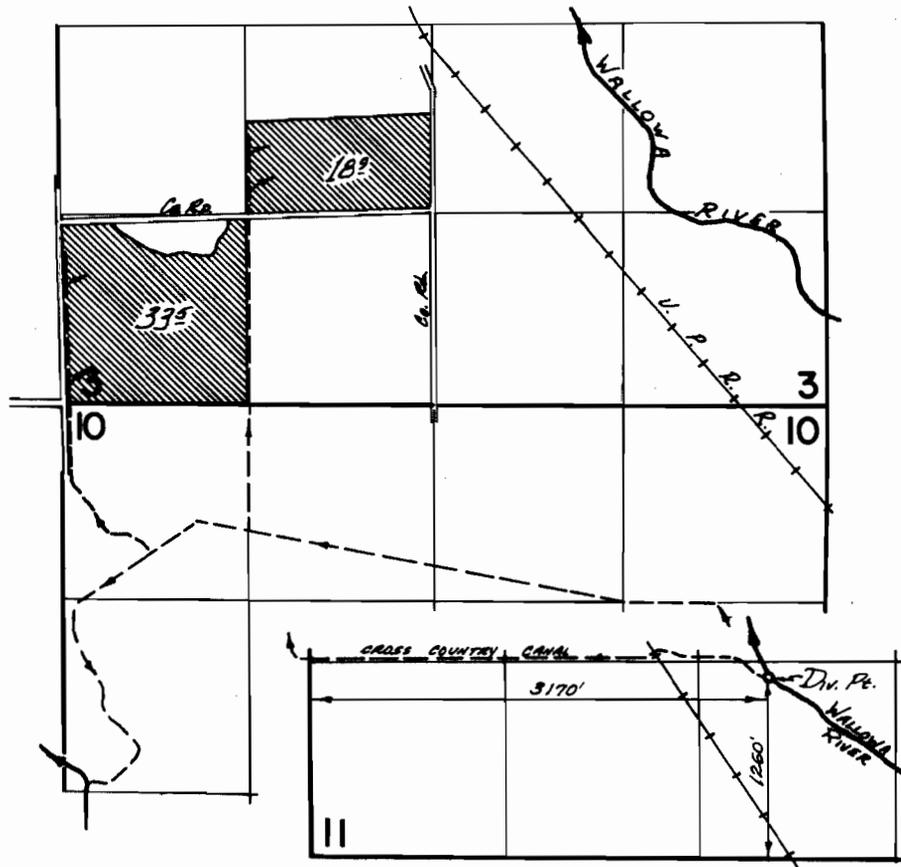

FINAL PROOF SURVEY
UNDER

Application No. 46059 Permit No. 34421
IN NAME OF

EDITH HAUN CLARK

Surveyed Aug. 9 1973, by D. Nobby