


T.5N.,R.43E.,W.M.

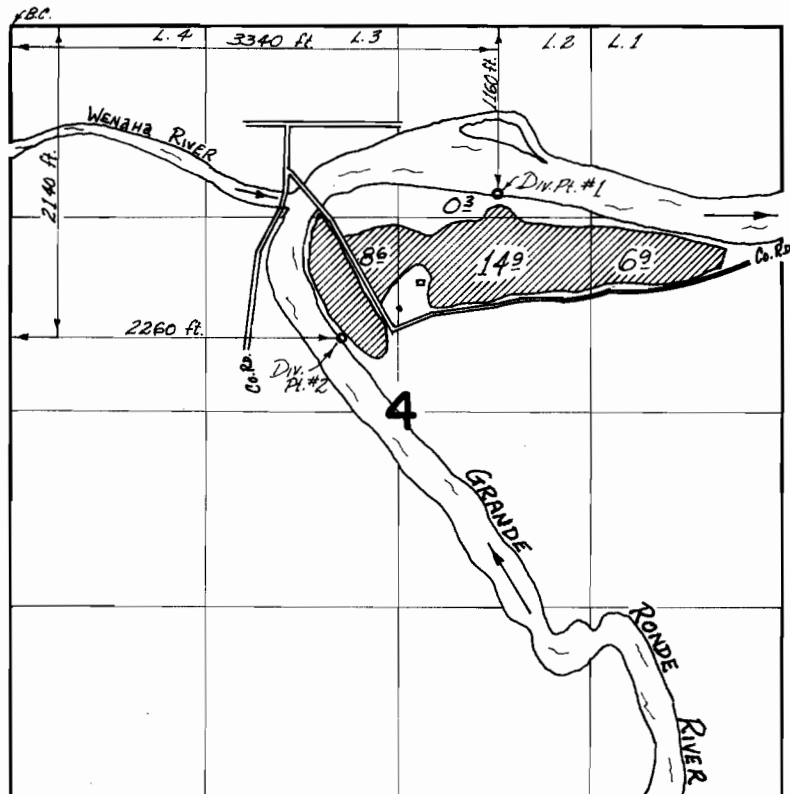

FINAL PROOF SURVEY
UNDER

Application No. 47963 Permit No. 35978
IN NAME OF

CECIL F. WALDRIP

Surveyed AUG. 14 1973, by D. NORBY