



T.2S.,R.44E.,W.M.

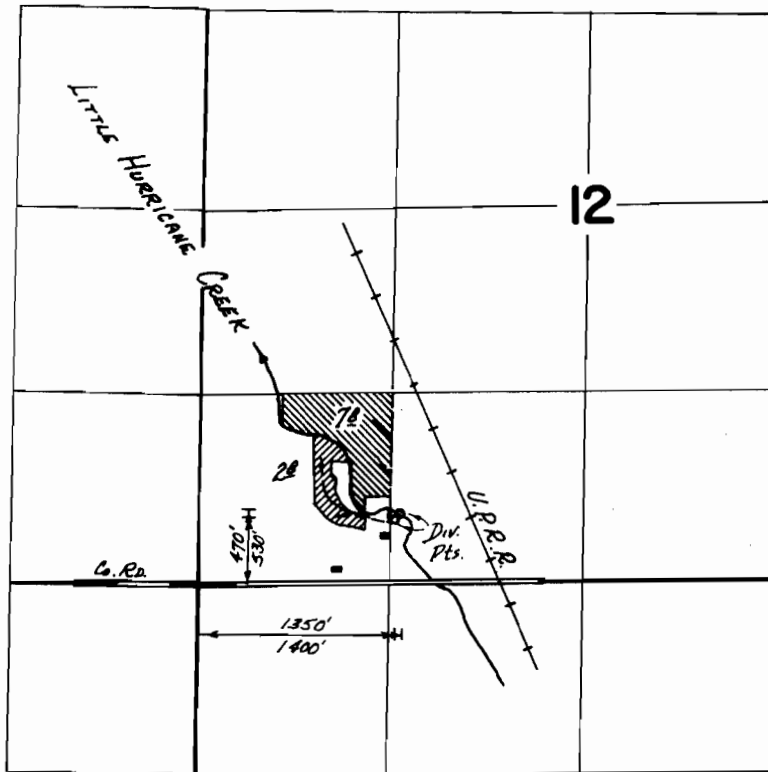

 PRIMARY

 SUPPLEMENTAL

FINAL PROOF SURVEY
UNDER

Application No. 48950 Permit No. 36653
IN NAME OF

RAY & CORNEIL T. HUGHES

Surveyed Aug. 7 1973, by D. Norey