


# T.1S., R.3W., W.M.

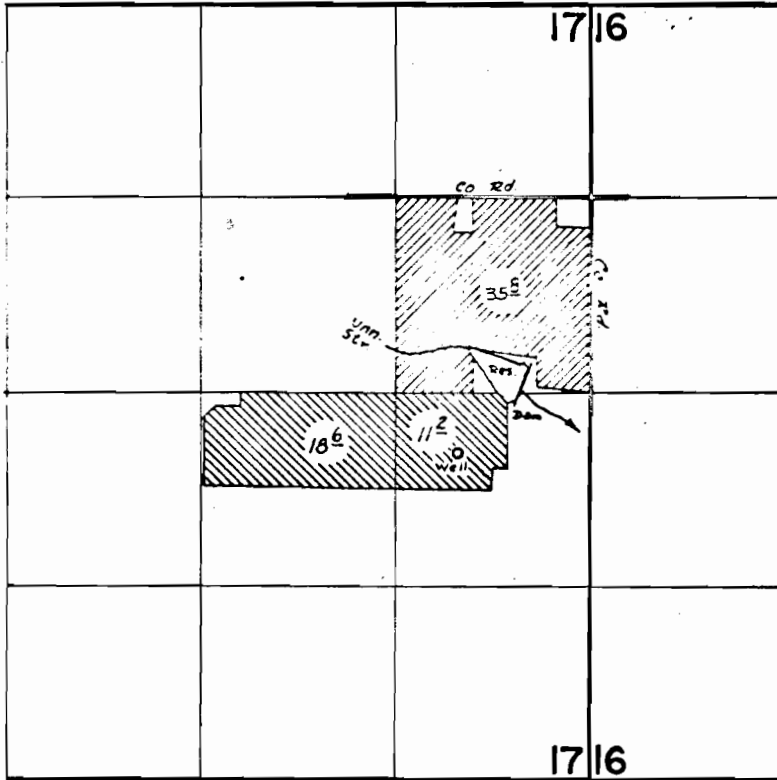

DIV PT. LOCATED: 1300' S & 480' W FROM SE COR NE $\frac{1}{4}$  NE $\frac{1}{4}$  SEC 17.  
 WELL LOCATED: 1730' S & 900' W FROM SE COR NE $\frac{1}{4}$  NE $\frac{1}{4}$  SEC 17.

## FINAL PROOF SURVEY UNDER

R-46198                      R-5424  
 46213                        34131  
 Application No. G-4401    Permit No. G-4148  
 IN NAME OF



DONALD C. JESSE

Surveyed June 12, 1972, by D. Norby