


T.1S. R.38E. W.M.

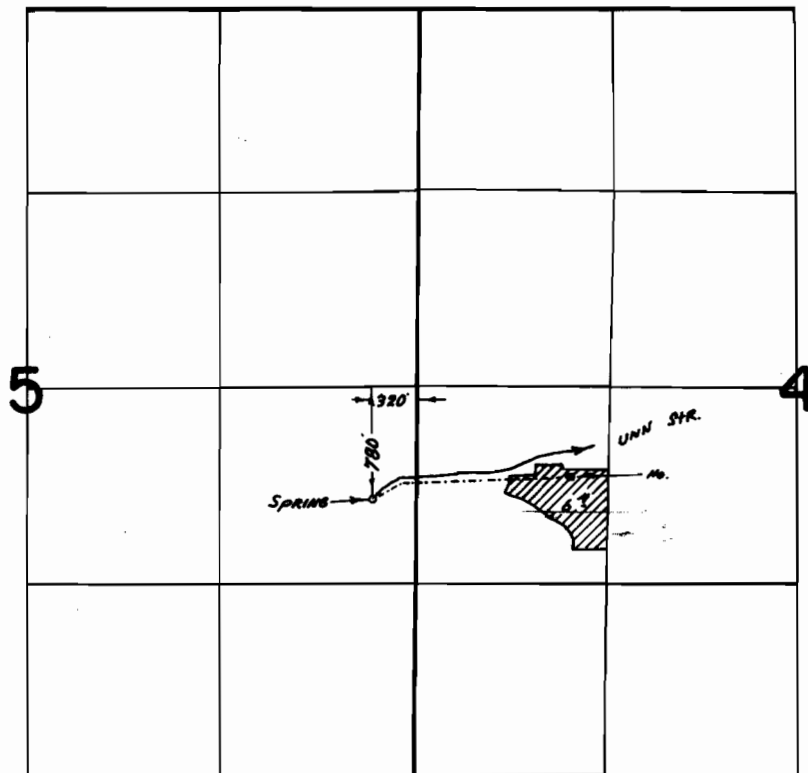

FINAL PROOF SURVEY
UNDER

Application No. 49237 Permit No. 92374
IN NAME OF

RAY O. & MARY ALICE BAKER

Surveyed JULY 12 1978, by R. B. MUCKEN