


# T.I.S.R.2 & 3W.W.M.

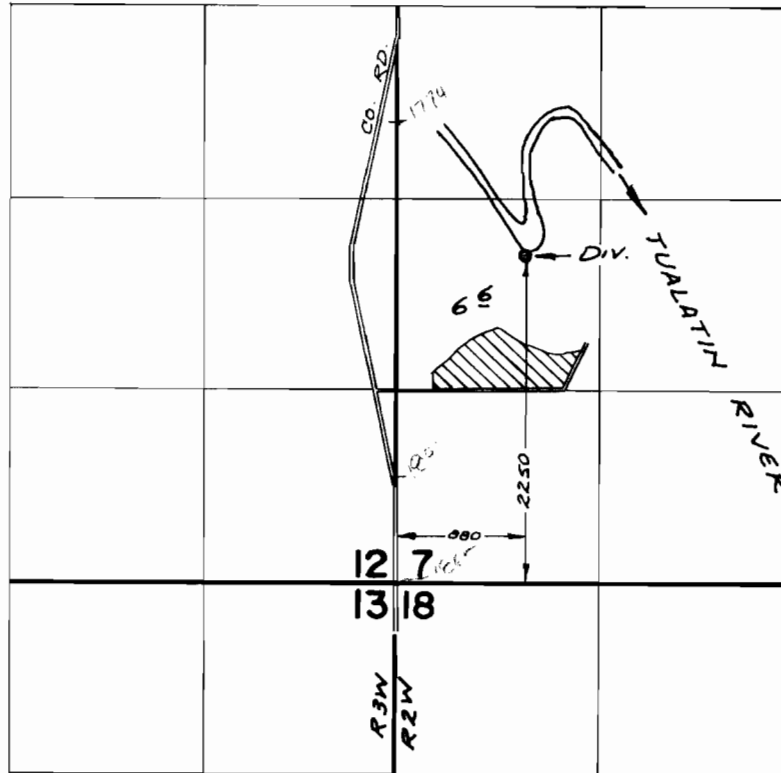

## FINAL PROOF SURVEY UNDER

Application No. 48050 Permit No. 36029  
IN NAME OF

CARL ANDREW PIERSON

Surveyed Nov. 3, 1972, by R. MUCKEN