


T.4N. R.10W. W.M.

PACIFIC OCEAN

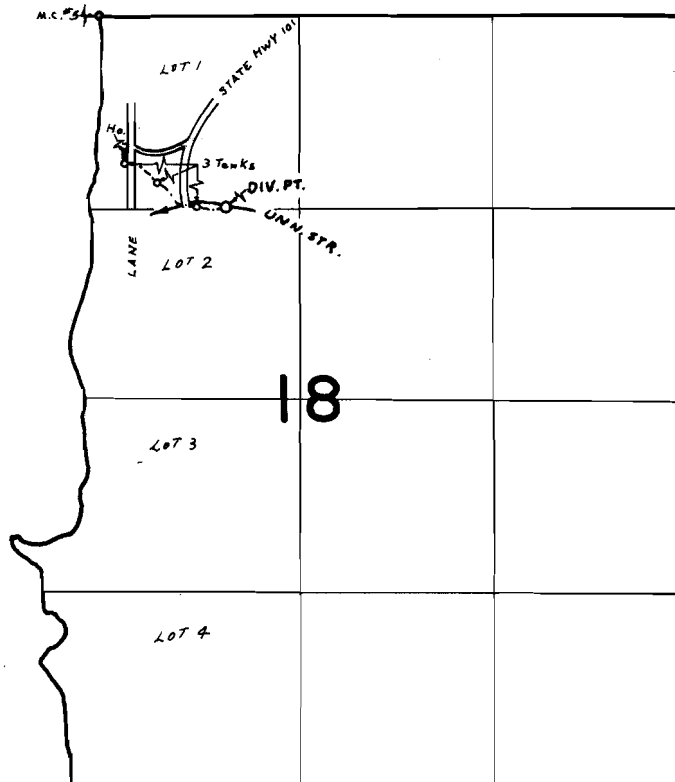

DIV. PT. LOC: 1310' S. & 870' E. From meander cor. #5 at N.W. cor. Sec. 18

FINAL PROOF SURVEY
UNDER

Application No. 43570 Permit No. 32303
IN NAME OF

ALLAN S. and ESTELLA F. RYTSALA

Surveyed MAY 1, 1973, by R. MUCKEN