


T.4N. R.8W. W.M.

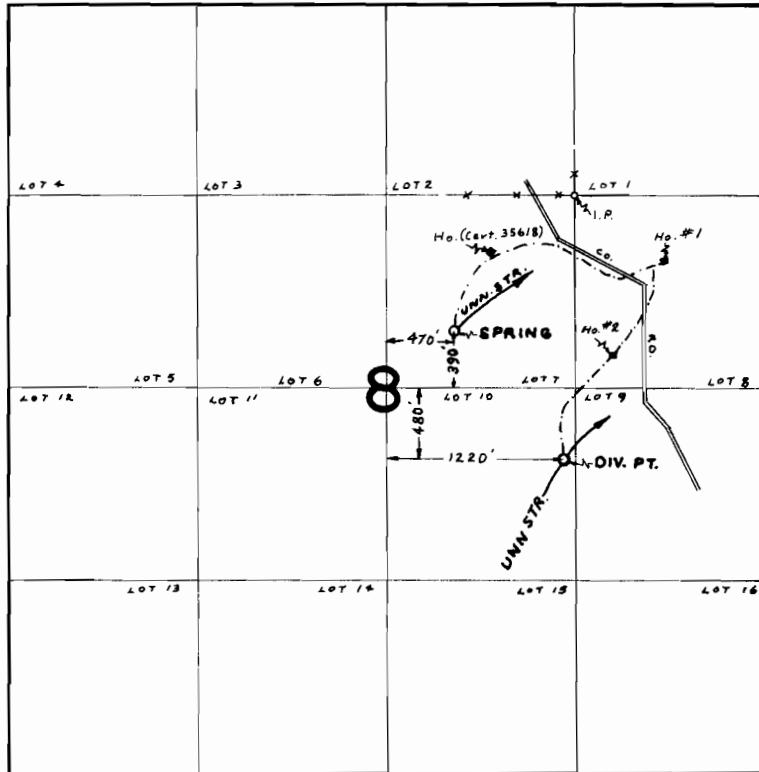

FINAL PROOF SURVEY
UNDER

Application No. 44721 Permit No. 33505

IN NAME OF

LYNN A. BRIGHAM

Surveyed MAY 4, 19 73, by R. MUCKEN