


T.4N. R.9W. W.M.

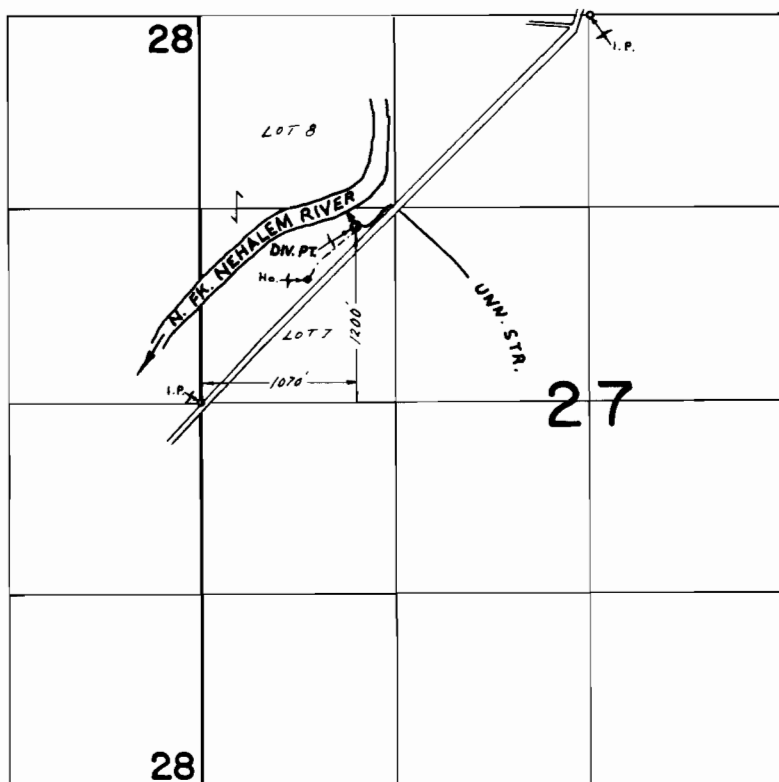

**FINAL PROOF SURVEY**  
UNDER

Application No. 46609 Permit No. 34830  
IN NAME OF

RONALD S. and DEBORAH C. PITTS

Surveyed MAY 3, 19 73, by R. MUCKEN

1973-J *RAF*