


T.6N. R.10W. W.M.

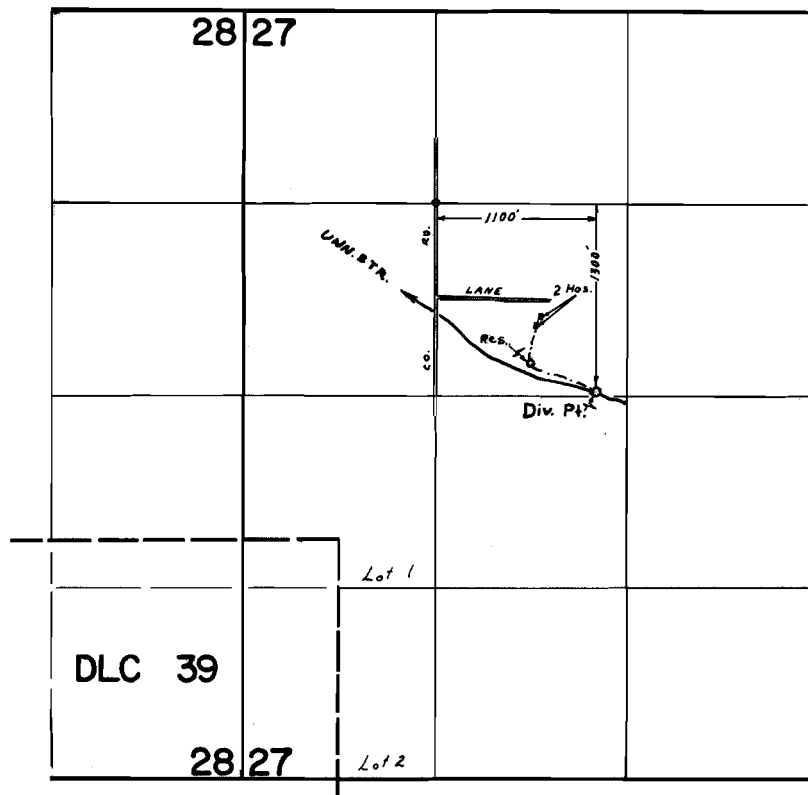

FINAL PROOF SURVEY
UNDER

Application No. 48229 Permit No. 35264
IN NAME OF
FRANK ALTO

Surveyed APRIL 30, 1973, by R. MUCKEN