


T.39S.,R.4W.,W.M.

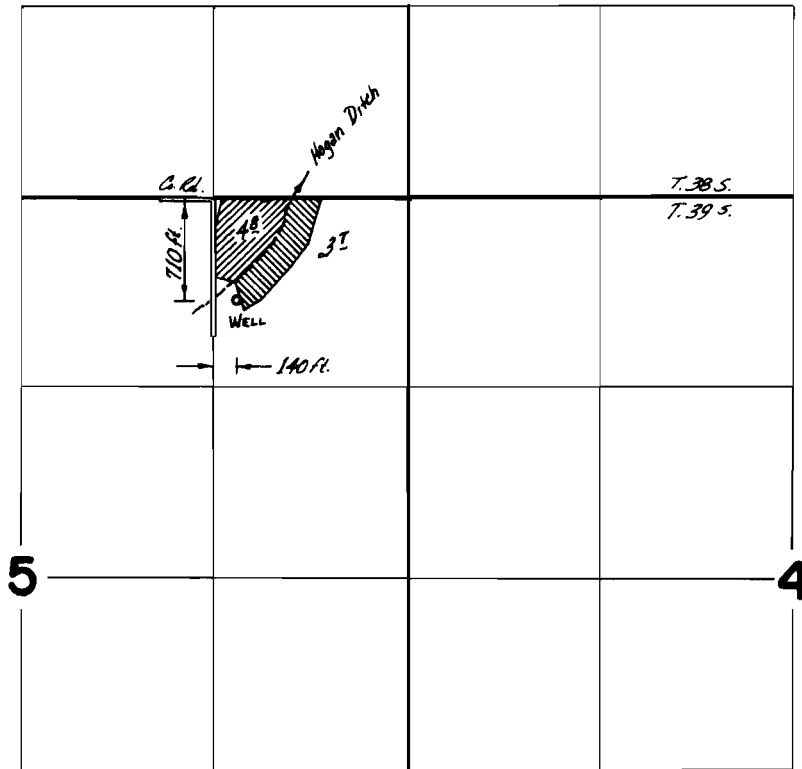

 *Suppl*
 *Primary*

FINAL PROOF SURVEY
UNDER

Application No. G-3899 Permit No. G-3664
IN NAME OF

HOWARD W. PIETE

Surveyed Oct. 11 1973, by D. Noreby