


T. 35S.R.2W. W.M.

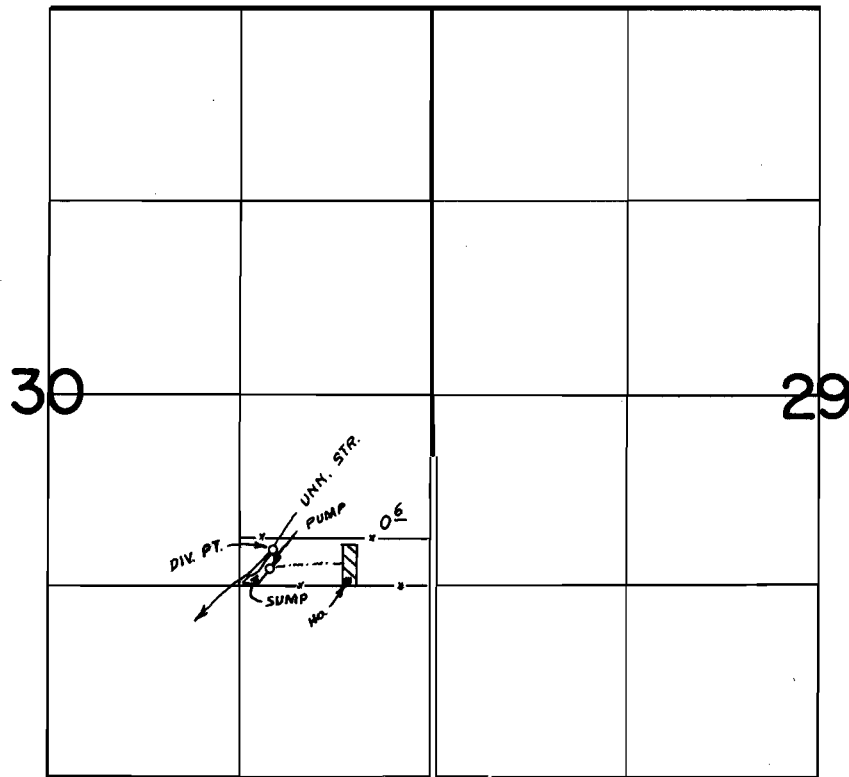

DIV. PT. 1580' N & 1090' W FROM SE COR. SEC. 30

FINAL PROOF SURVEY
UNDER

Application No. 41729 Permit No. 31155
IN NAME OF

BILLY & PATSY DAMERON

Surveyed OCT 16 19 73 by R.G. MUCKEN