


T.35&36S.R.19 &20E.W.M.

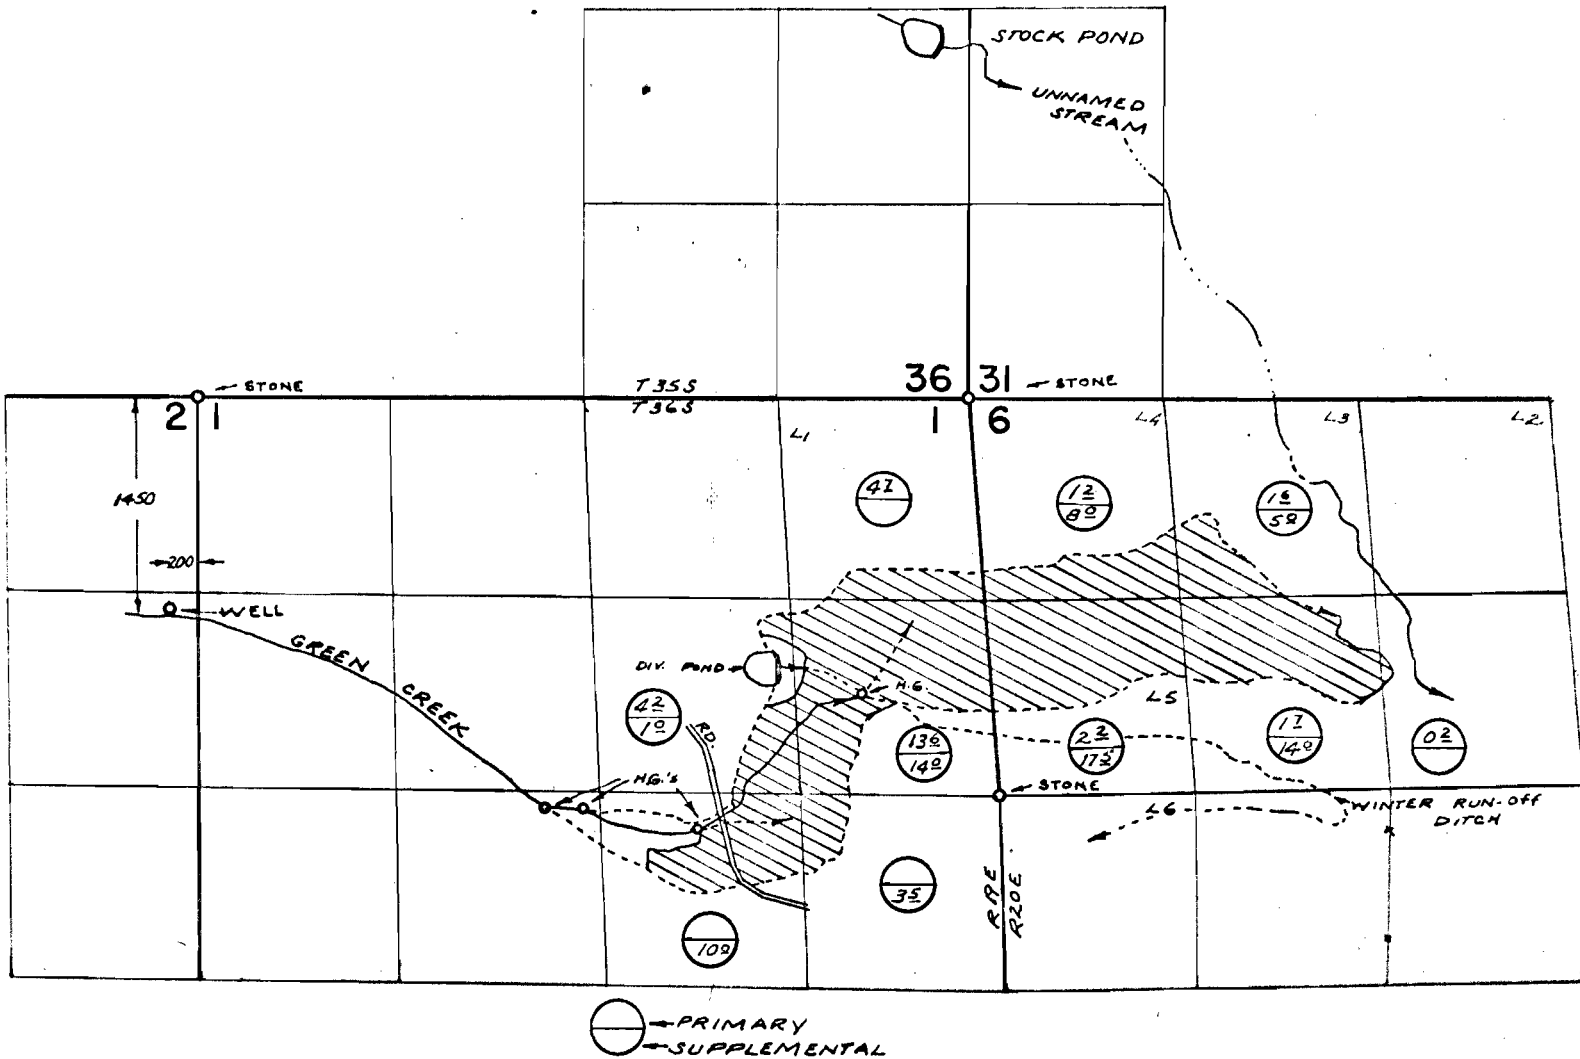

FINAL PROOF SURVEY

UNDER

R- 41673

R- 4693

APPLICATION NO. G-2310

PERMIT NO. G-2197

IN NAME OF

JAMES - E. - AND - AGNES - FLIPPIN ELDER

SURVEYED AUG. 25, 1973 BY R. MUCKEN