


T9420

T. 25 S. R. 17 E. W.M.

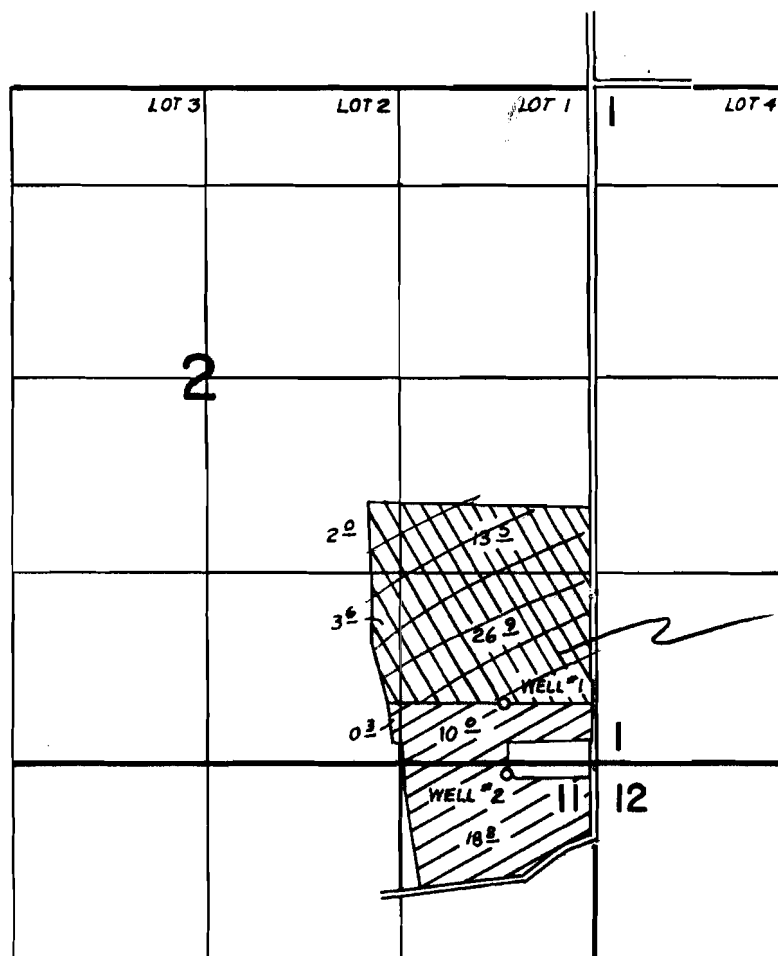

*this Portion
cancelled
APR 9, 1976
See cut #
43774*



WELL #1 4210' S & 600' W FROM NE COR. SEC. 2

WELL #2 4700' S & 380' W FROM NE COR. SEC. 2

FINAL PROOF SURVEY UNDER

Application No. G-5173 Permit No. G-4904
IN NAME OF

FELIX A. FRAZEE

Surveyed AUG. 22, 1973, by R.G. MUCKEN