


P.G-4938
41095

T. 40S.R. 20E.W.M.

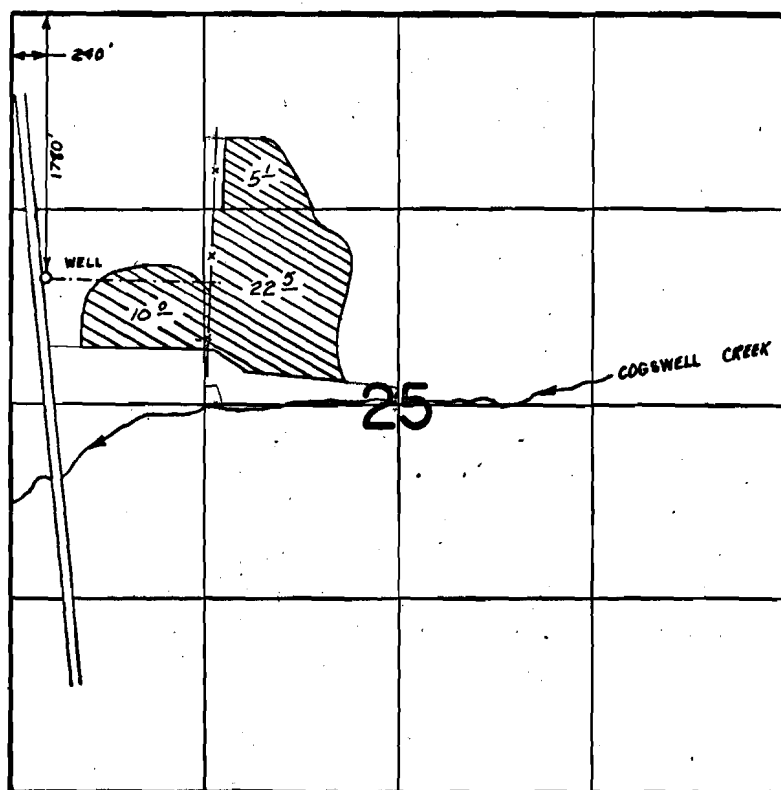

FINAL PROOF SURVEY
UNDER

Application No. G-5186 Permit No. G-4938
IN NAME OF

STEVE H. & IRENE M. BAILEY, H&W

Surveyed AUG-24 1973, by R.G. MUCKEN