


T. 27 S.R. 15E.W.M.

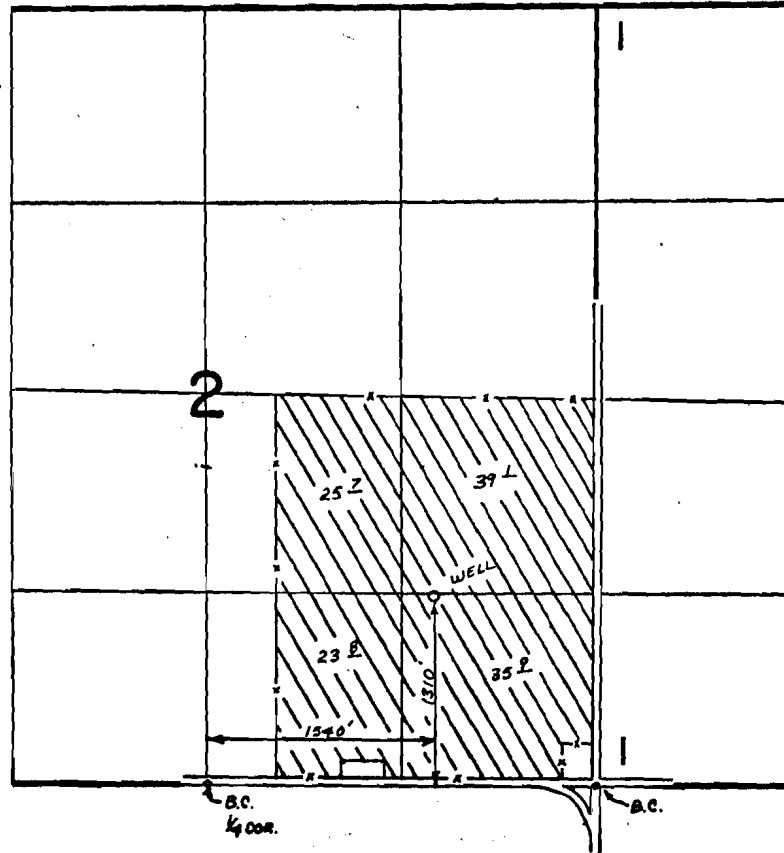

FINAL PROOF SURVEY
UNDER

Application No. G-5475 Permit No. G-4979
IN NAME OF

HAROLD A. & LOIS L. MILES (W, P, S)

Surveyed AUG 21 1973, by R.G. MUCKEN