


T.35&36S.R.19&20E.W.M.

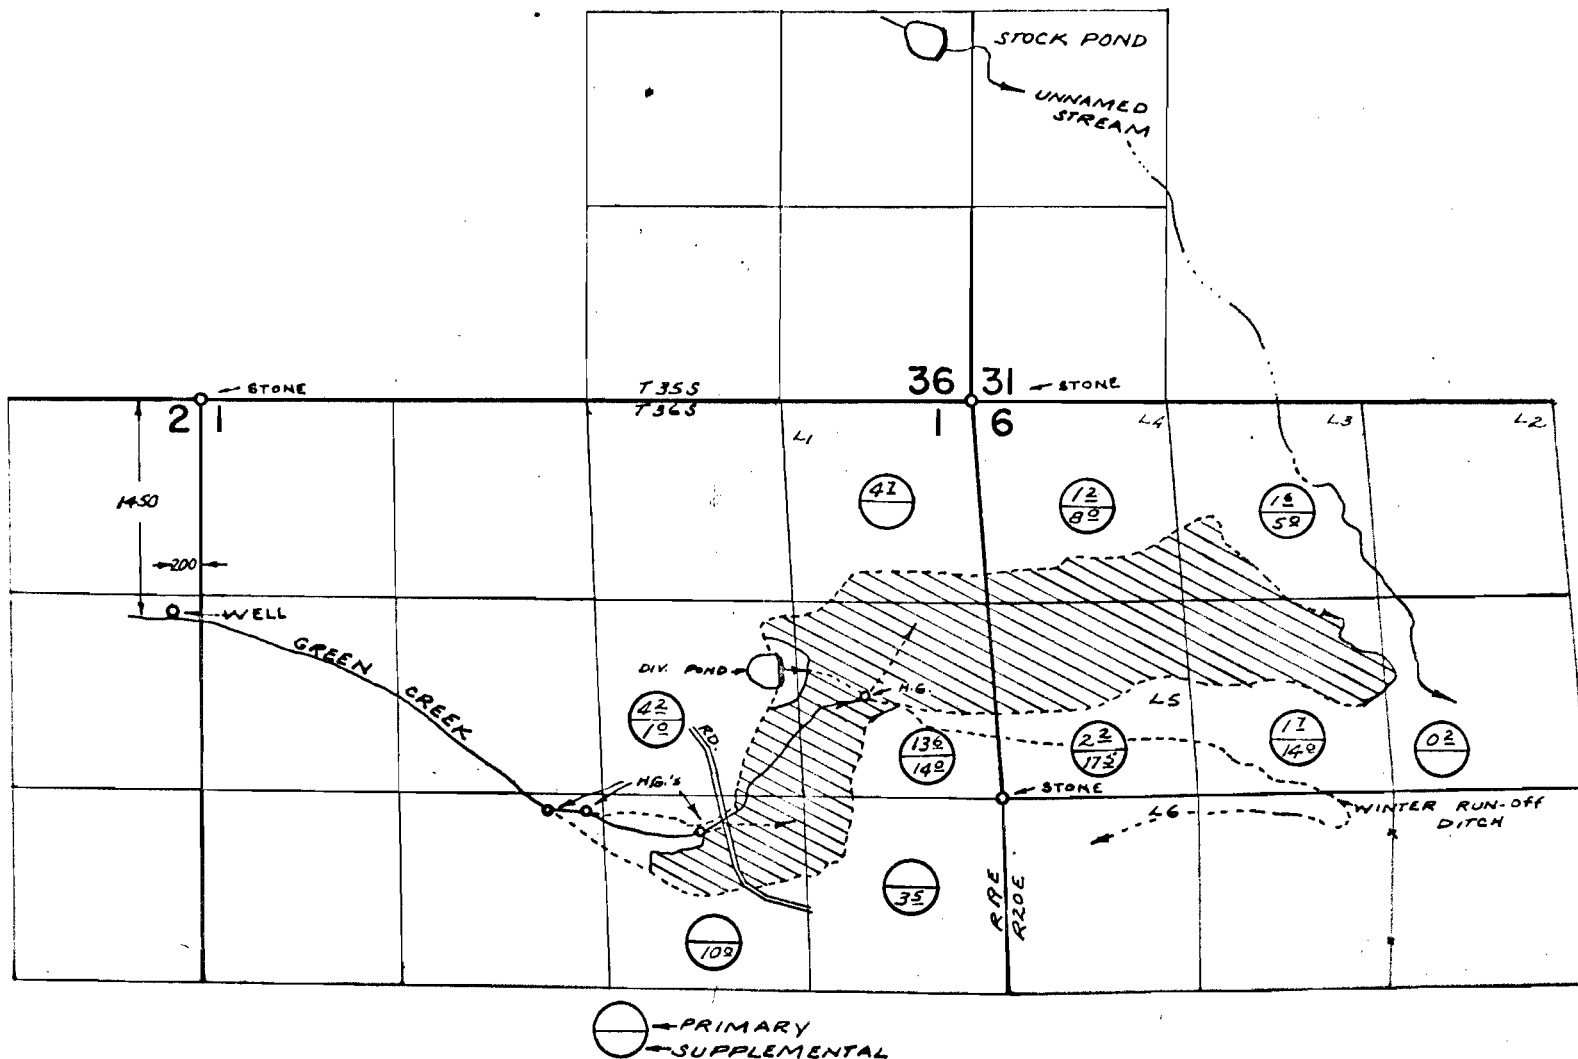

FINAL PROOF SURVEY

UNDER

R- 41673

R- 4693

APPLICATION NO. G- 2310

PERMIT NO. G- 2197

IN NAME OF

JAMES E. AND AGNES EUPPIN ELDER

SURVEYED AUG. 25, 1973 BY R. MUCKEN