


T.38 & 39S. R.19E. W.M.

R 5545 to R 5568
41102 41105

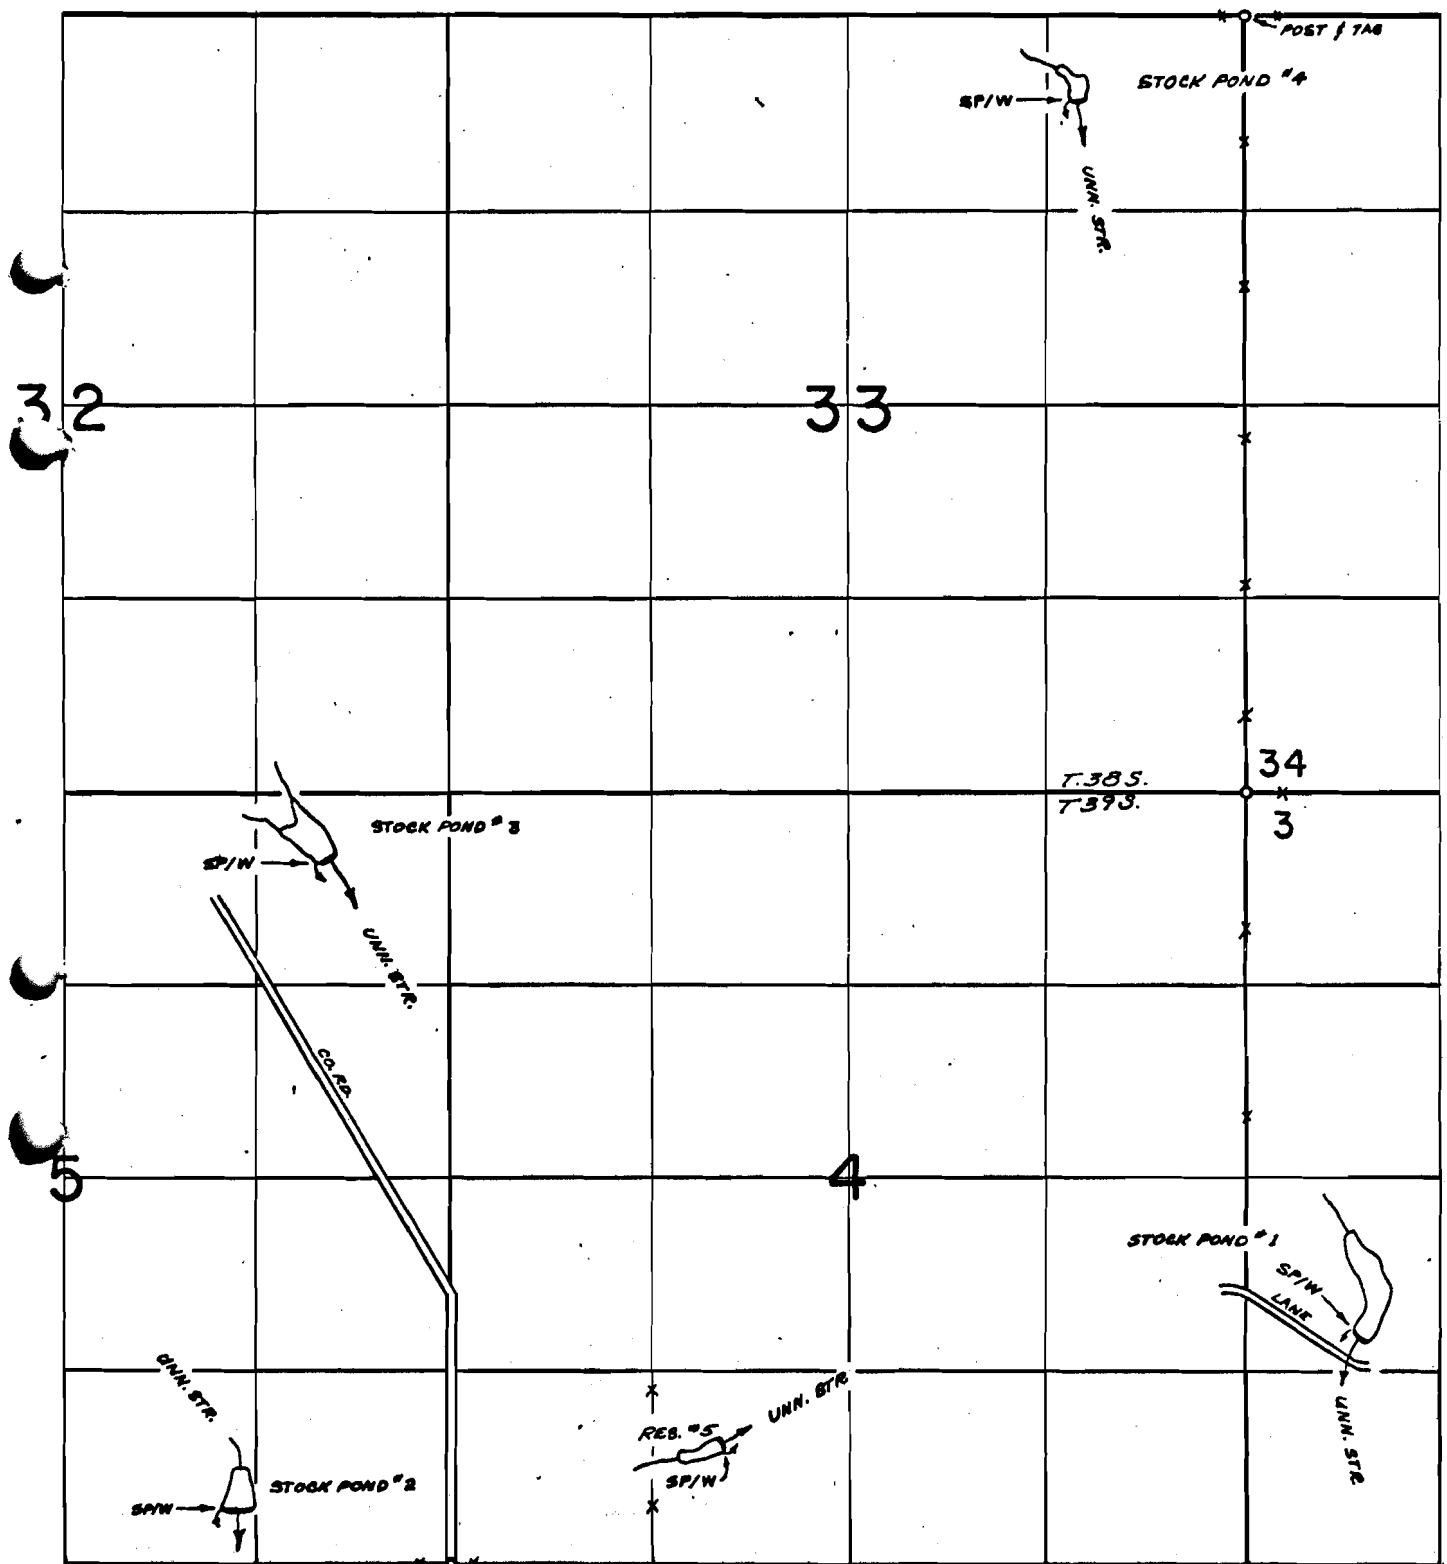

FINAL PROOF SURVEY

R-16602
R-16603
R-16604
R-16605

R-5565
R-5566
R-5567
R-5568

Application No. R-1777... Permit No. R-5768.....

IN NAME OF
COTTONWOOD CATTLE COMPANY

Surveyed AUGUST 30 1973, by R. MUCKEN