


T.38 & 39S.R.19E.W.M.

R-5768
41108

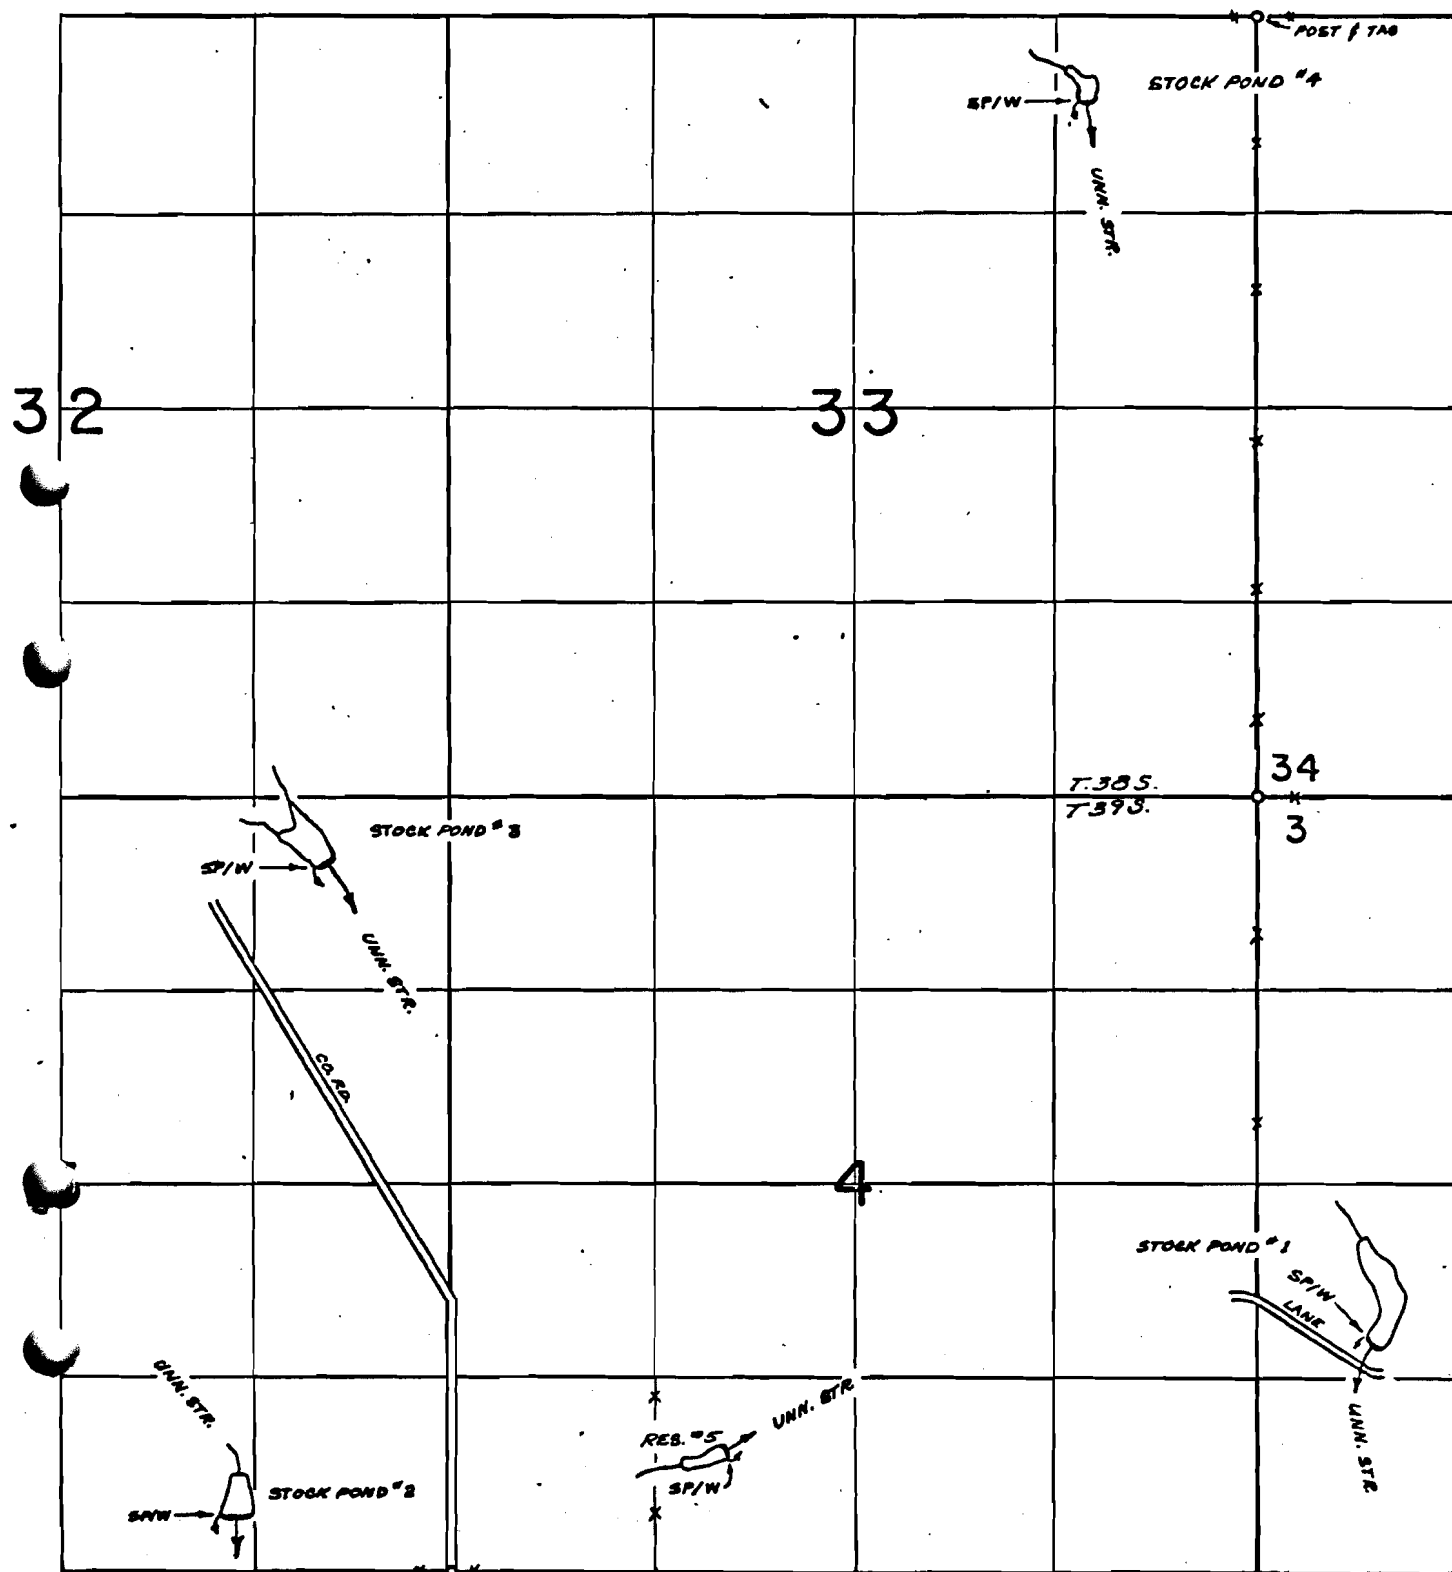

FINAL PROOF SURVEY

R-46602 R-5565
 R-46603 R-5566
 R-46604 R-5567
 R-46605 R-5568
 Application No. R-4777... Permit No. R-5768.....

IN NAME OF
COTTONWOOD CATTLE COMPANY

Surveyed AUGUST 30 1973¹, by R. MUCKEN