


T.38 & 39S.R.19E.W.M.

R-5768
41108

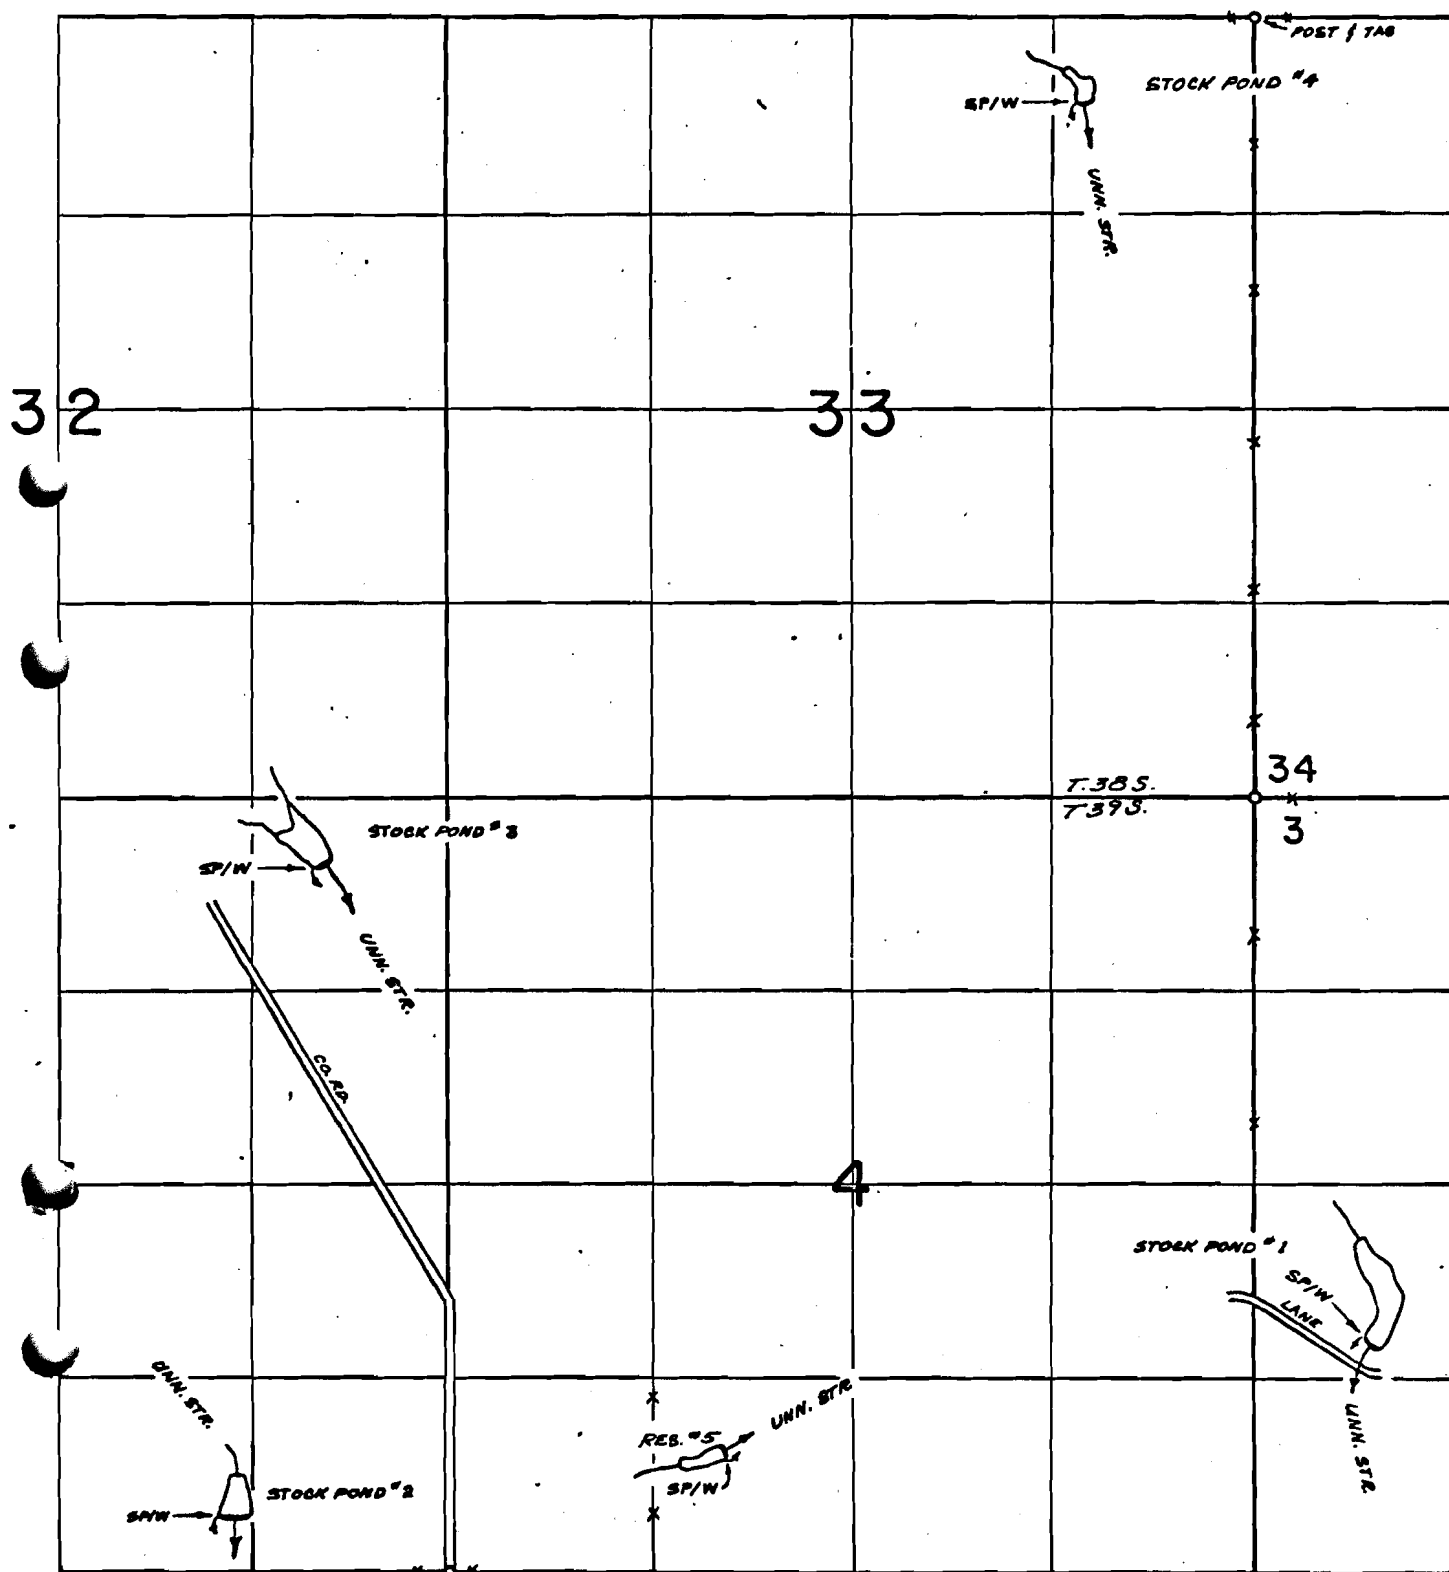

FINAL PROOF SURVEY

R-46602 R-5565
R-46603 R-5566
R-46604 R-5567
R-46605 R-5568

Application No. R-47771... Permit No. R-5768.....

IN NAME OF
COTTONWOOD CATTLE COMPANY

Surveyed AUGUST 30 1973, by R. MUCKEN