


T.38 & 39S. R.19E. W.M.

R 5545 to R 5548  
41102 41105

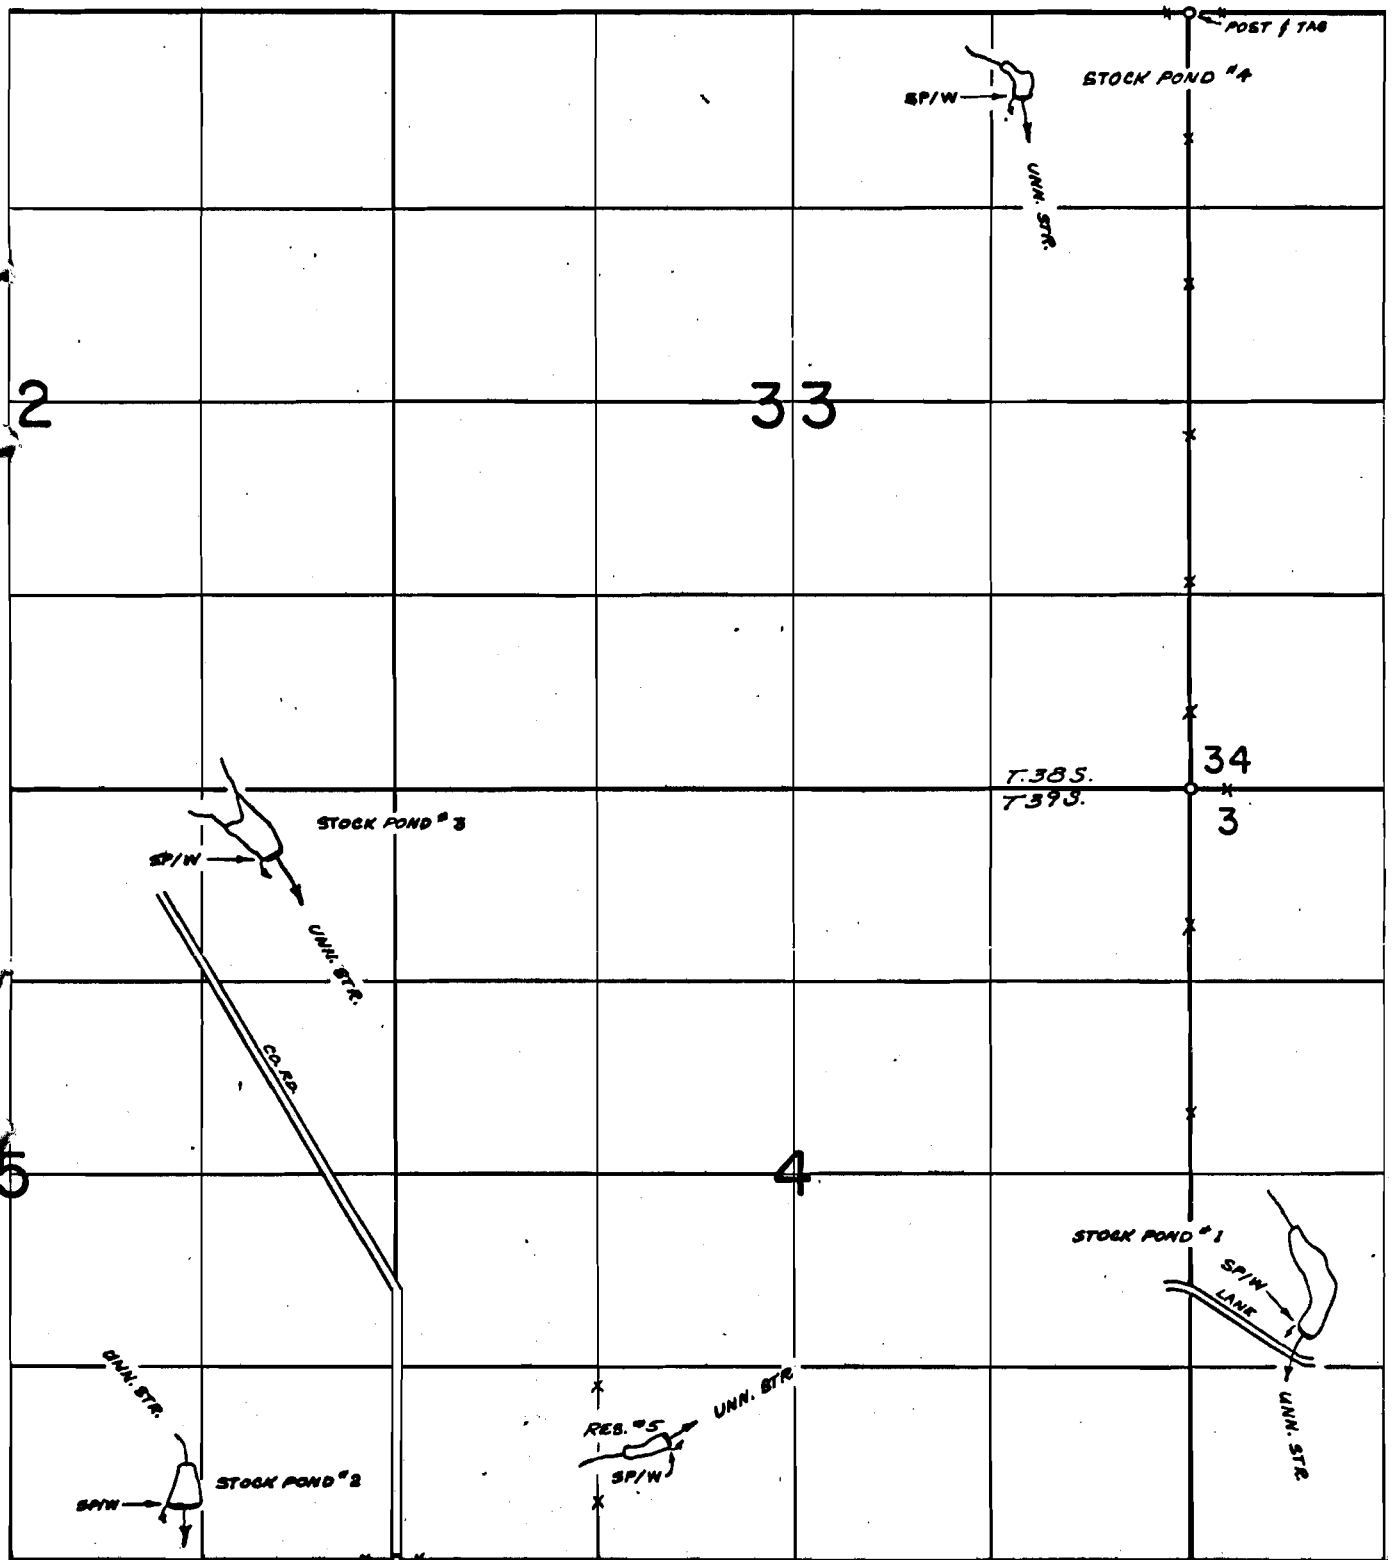

## FINAL PROOF SURVEY

Application No. R-46602 Permit No. R-5565  
R-46603 R-5566  
R-46604 R-5567  
R-46605 R-5568  
R-47771 R-5748

IN NAME OF  
COTTONWOOD CATTLE COMPANY

Surveyed AUGUST 30 1973, by R. MUCKEN