


MOSS SPRING

29160
41107

THOMAS CREEK R.D. FOREST SERVICE

SCALE - 4" = 1 MI.

10/2/62 J.W.L.

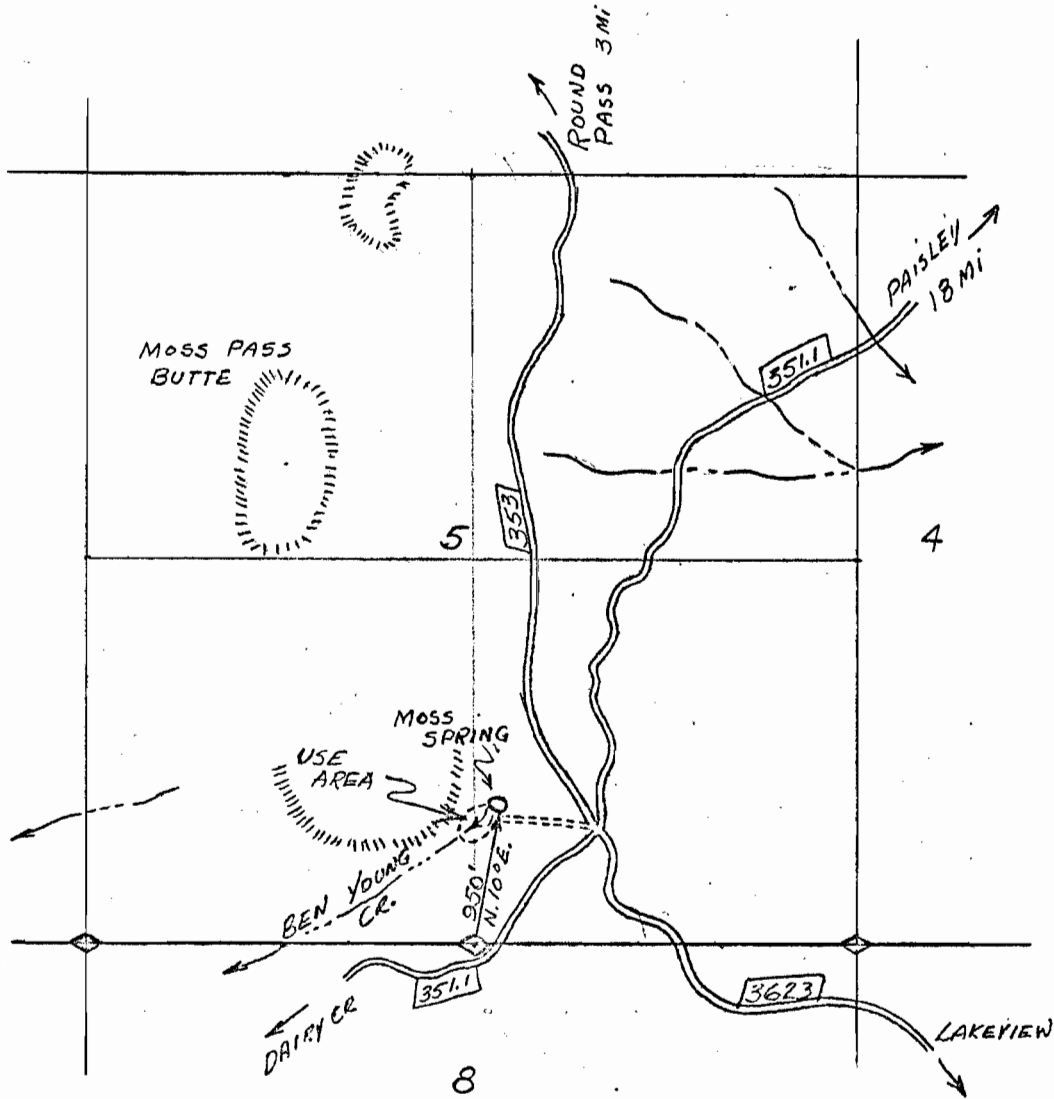

T
36
S

6

5

4

8

R 18 E

Application No. 38172
Permit No. 29160

36-18 ✓