
P. 31057
41109

T. 40S. R. 19E. W.M.

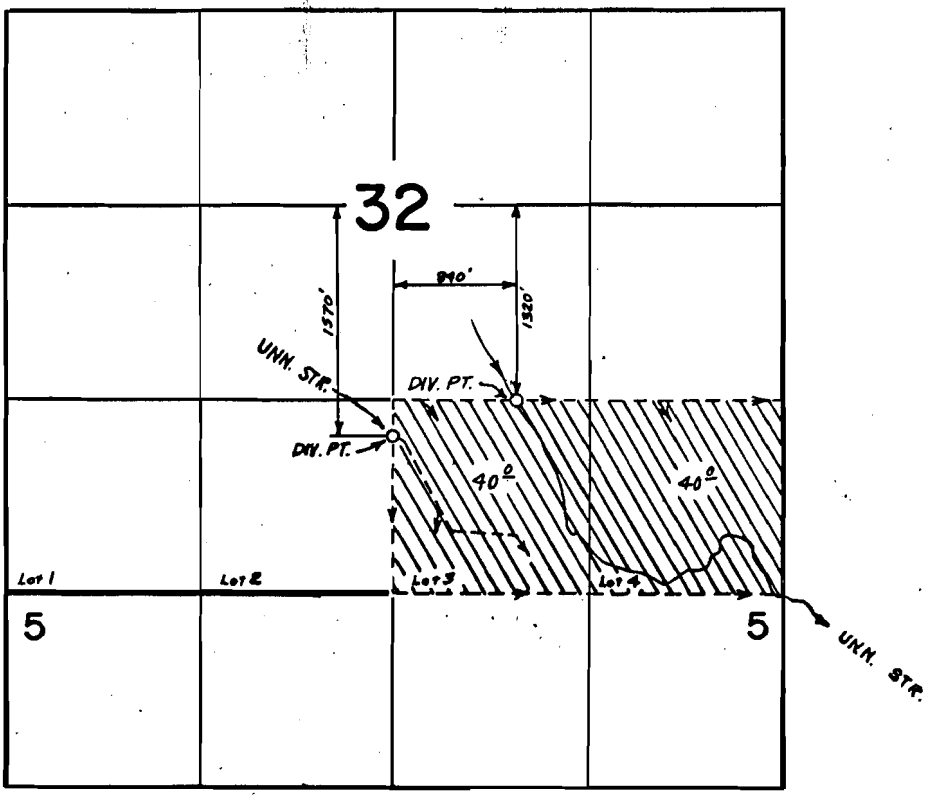

10-6-65

FINAL PROOF SURVEY
UNDER

Application No. 41467 Permit No. 31057
IN NAME OF

LYNN R. ALBERTSON ✓

Surveyed AUG 24 19 73, by R.G. MUCKEN

CNZ-5KK-192 DC