


P. 36023

41113

T. 40S. R. 18 & 19 E. W.M.

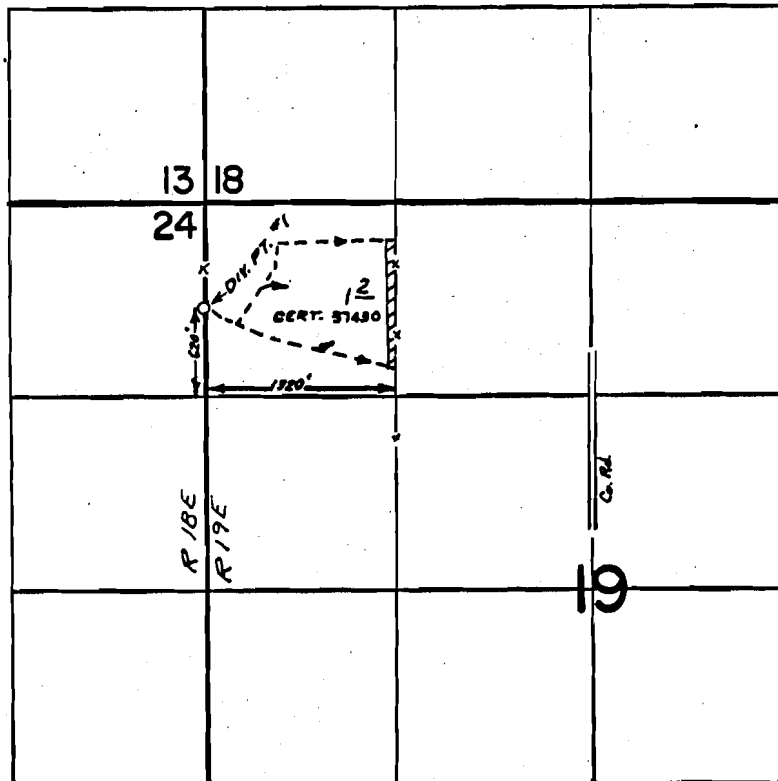

FINAL PROOF SURVEY UNDER

Application No. 48037 Permit No. 36023
IN NAME OF

DALE & SHIRLEY FRIDAY

Surveyed AUG 4 19 70, by R. G. MUCKEN