


T.II S. R. II W. W. M.

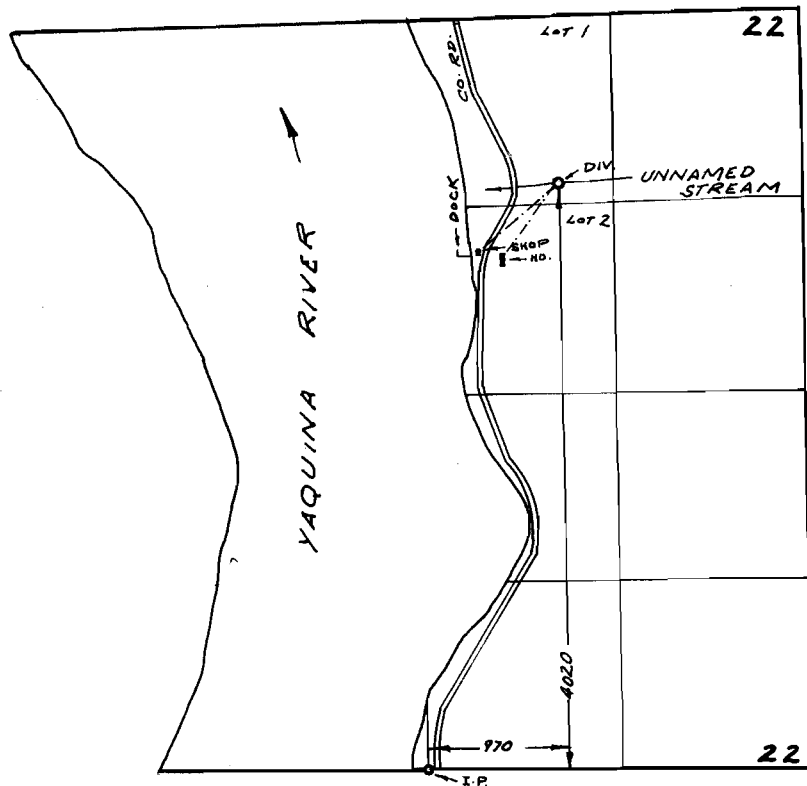

FINAL PROOF SURVEY
UNDER

Application No. 40696 Permit No. 30314
IN NAME OF

ROY L. EVERA J. SAWYER

Surveyed SEPT. 17, 1973, by R. MUCKEN