


T.10S.R.10W.W.M.

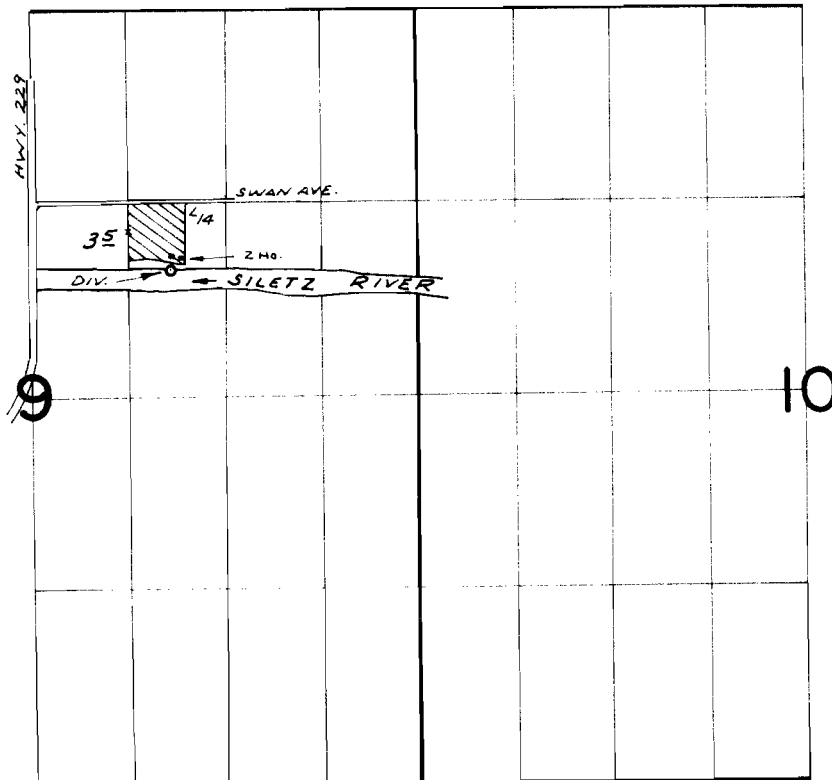

DIV. PT. LOC: 450' S. & 280' E. FROM N.W. COR. LOT 14, SEC. 9

FINAL PROOF SURVEY
UNDER

Application No. 42057 Permit No. 31481
IN NAME OF

RODNEY L. CALKINS

Surveyed SEPT. 20 1973, by R. MUCKEN