


T.I.O.S.R.I.O.W.W.M.

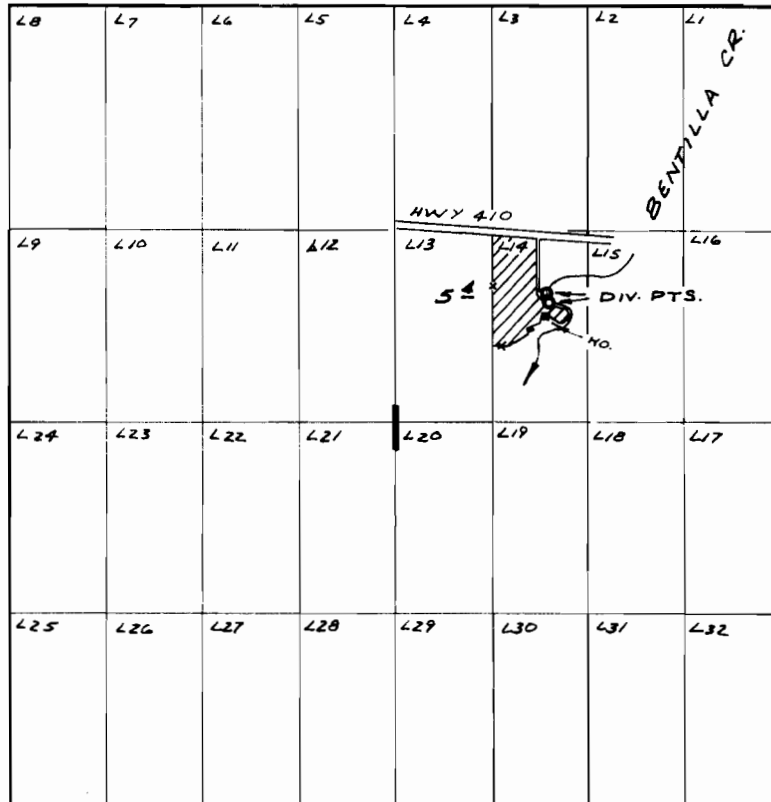

DIV. PTS. LOC: 820' N. & 260' W; 880' N & 280' W, BOTH FROM
SE. COR. LOT 14

FINAL PROOF SURVEY UNDER

Application No. 42152 Permit No. 31547
IN NAME OF

CHARLES D. YOUNG

Surveyed SEPT. 20, 1973, by R. MUGGEN