


T.I.S.R.I.W.W.M.

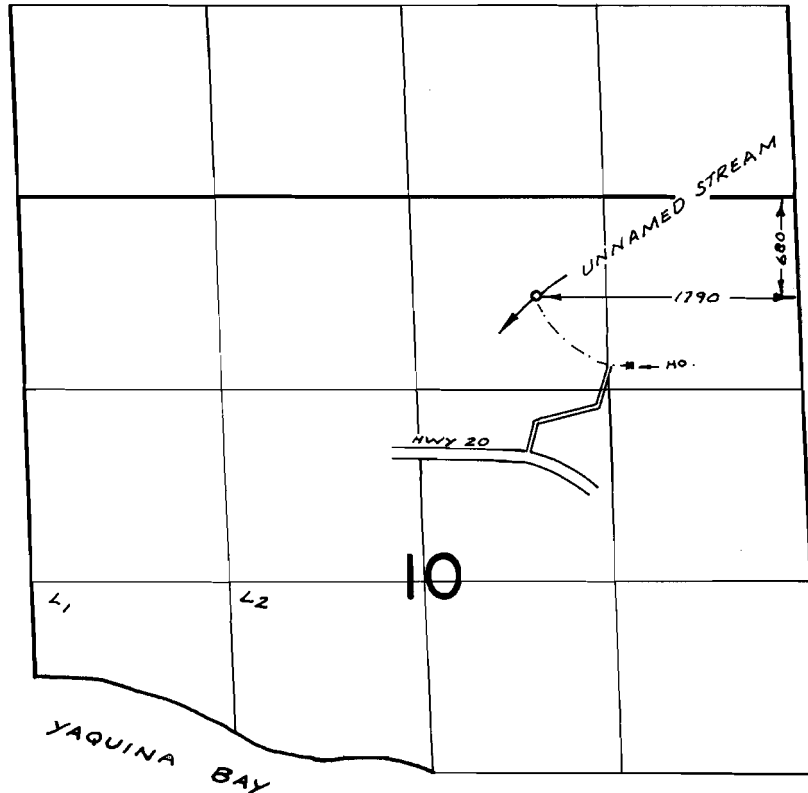

FINAL PROOF SURVEY
UNDER

Application No. 44144 Permit No. 32429
IN NAME OF

WILLIAM A. F. MARJORIE E. WILLIAMSON

Surveyed SEPT. 18, 1973, by R. MURKIN