


T. 10S. R. 10W. W.M.

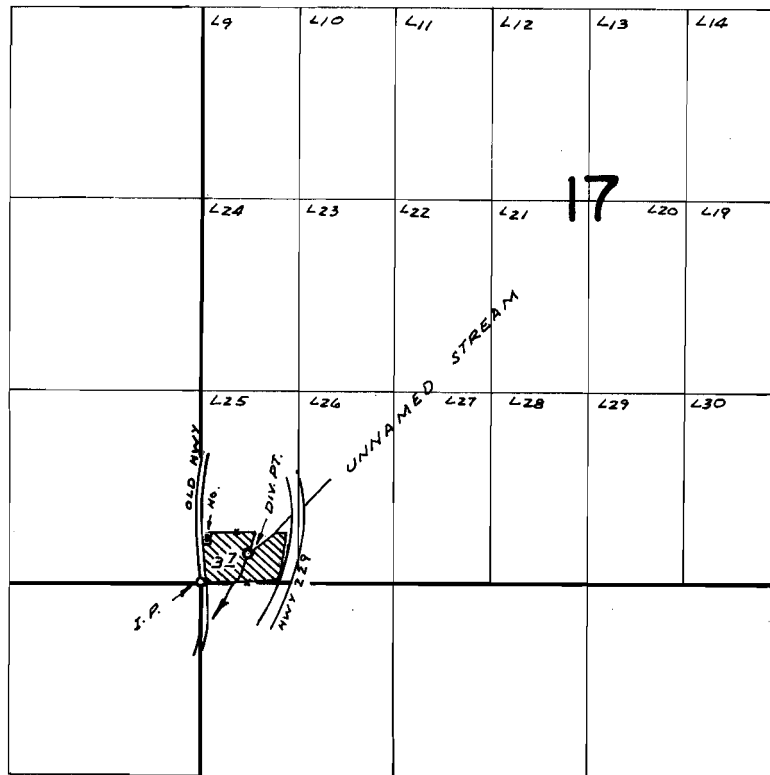

DIV. PT. LOC: 180' N & 330' E. FROM SW. COR. SEC. 17

FINAL PROOF SURVEY
UNDER

Application No. 44232 Permit No. 33039
IN NAME OF

WILLIAM H. BERRY

Surveyed SEPT. 18 19.73, by R. MUCKEN