


T.I.S.R.I.W.W.M.

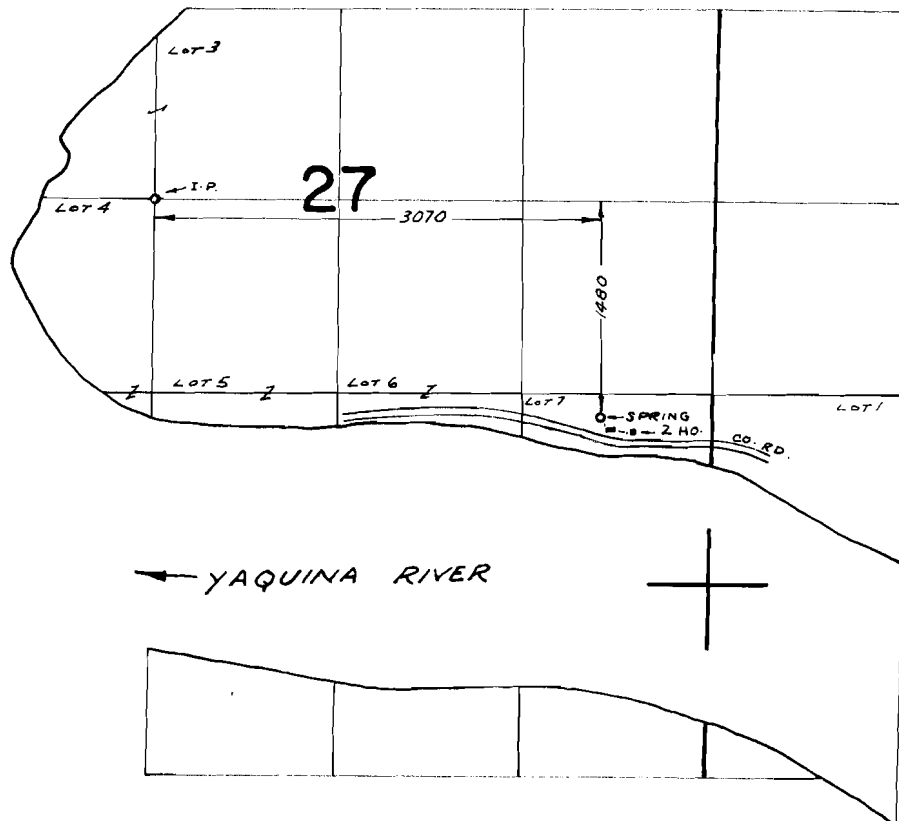

FINAL PROOF SURVEY
UNDER

Application No. 45017... Permit No. 33405...
IN NAME OF

GEORGE E. GALLEY

Surveyed SEPT. 17 1973, by R. MUCKEN