


T.IOS.R.IOW.W.M.

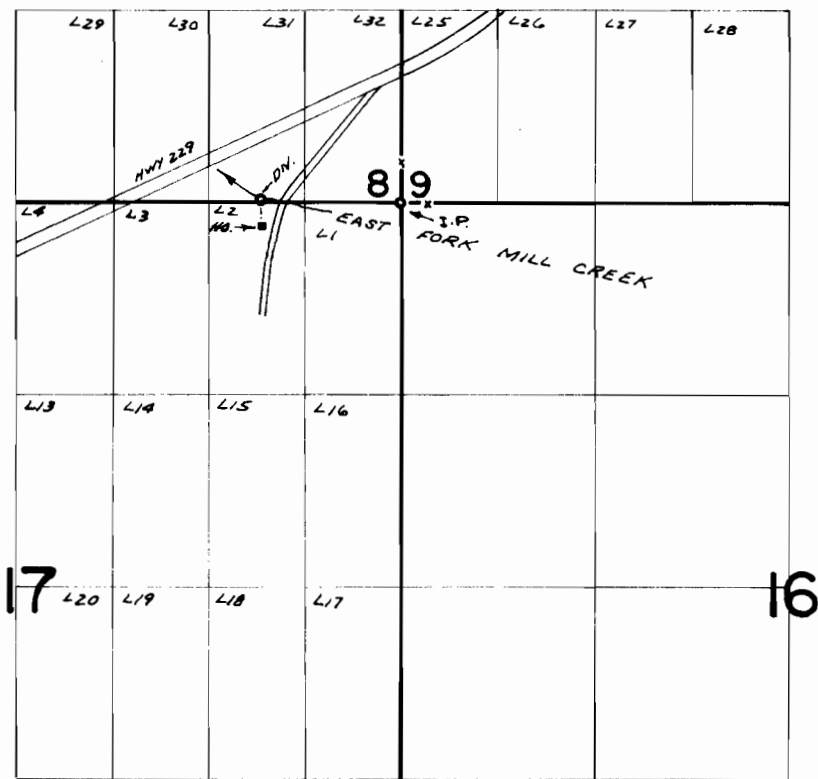

WELL LOC: 20'N. & 950'W. FROM S.E. COR. SEC. 8

FINAL PROOF SURVEY

UNDER

Application No. 45362 Permit No. 33868
IN NAME OF

WILLO CHANDLER

Surveyed SEPT. 19 1973, by R. MUCKEN