


T.6S.,R.10W.,W.M.

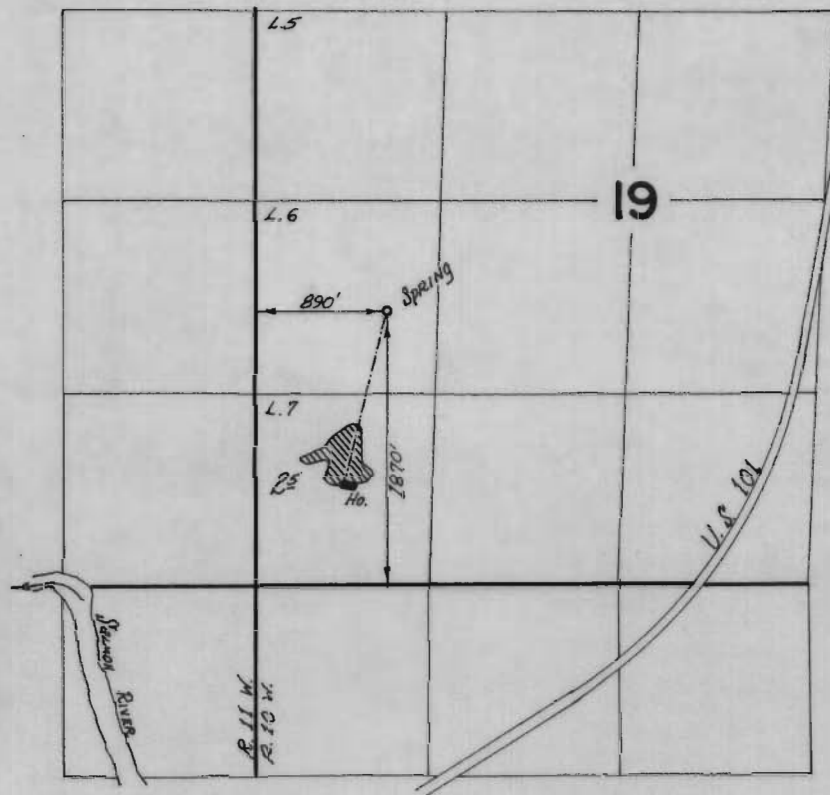

FINAL PROOF SURVEY
UNDER

Application No. 47625 Permit No. 35644
IN NAME OF

ZANE D. CHURCH

Surveyed Sept. 5 1973, by D. Norsey