


T.I.S.R.I.W.W.M.

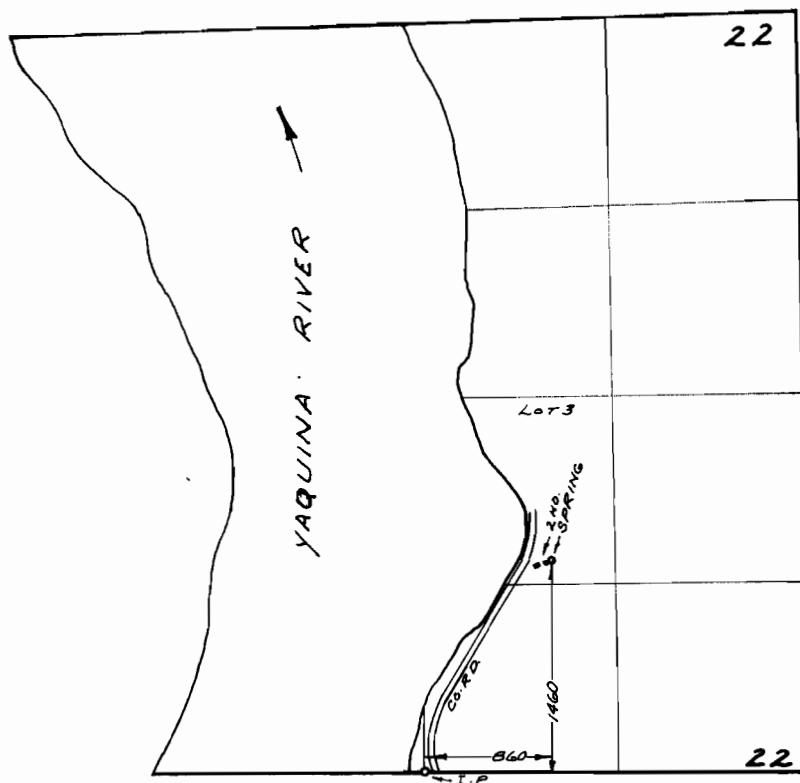

FINAL PROOF SURVEY
UNDER

Application No. 49858 Permit No. 36042
IN NAME OF

DOROTHY G. ODELL - IRENE M. NICHOLAS

Surveyed SEPT. 17 1913, by R. MUCKEN