


T.10 S.R.10W.W.M.

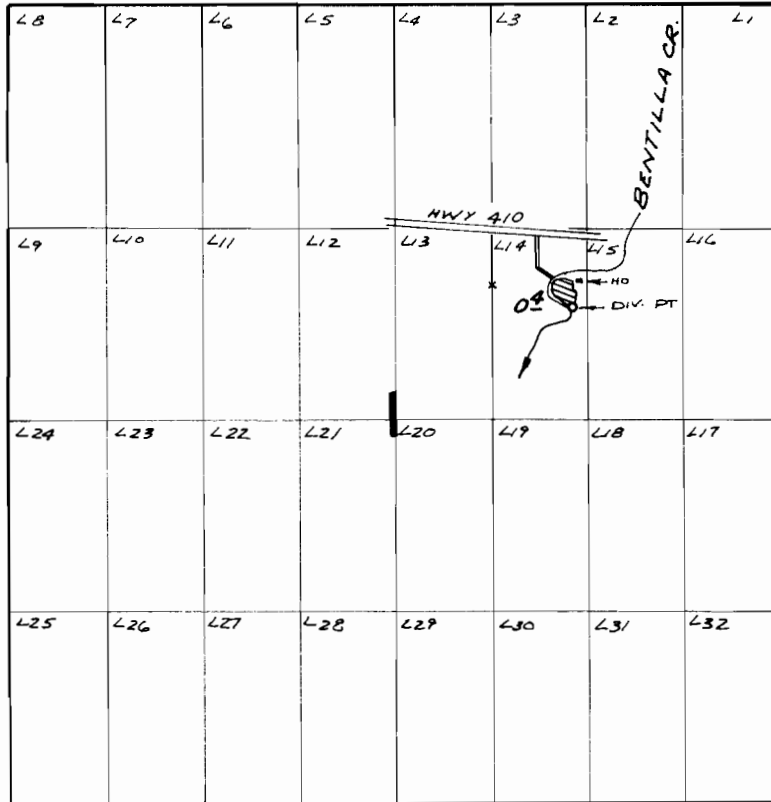

DIV. PT. LOC: 770' N. & 100' W. FROM S.E. COR. LOT 14

FINAL PROOF SURVEY UNDER

Application No. 48760 Permit No. 36570
IN NAME OF

ROBERT L. WATTS

Surveyed SEPT. 20, 1973, by R. MUCKEN