


T.I.O.S.R.I.O.W.W.M.

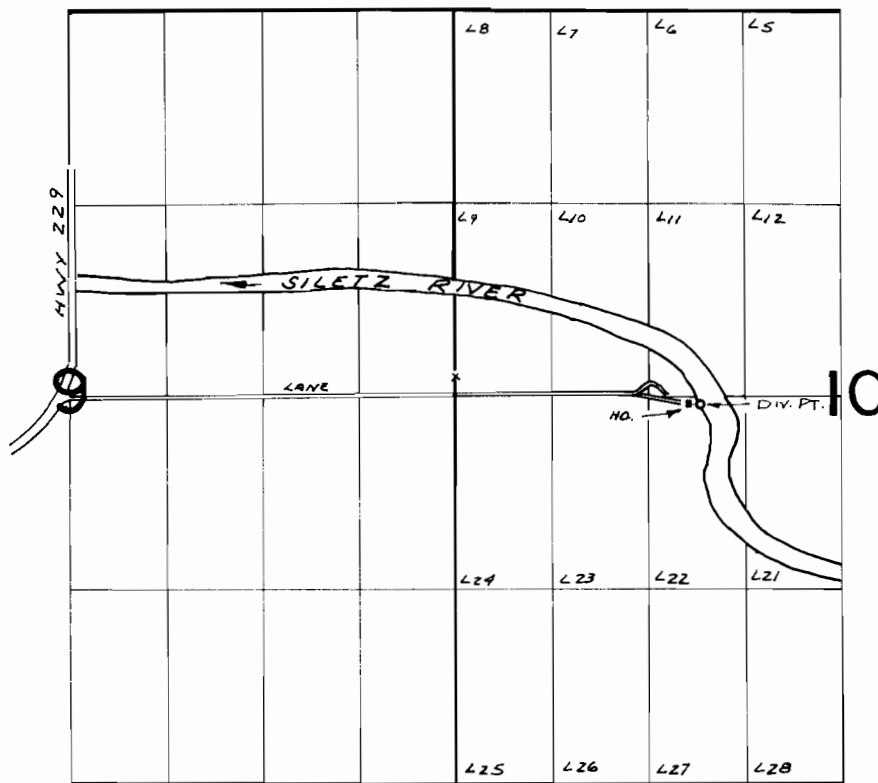

DIV. PT. LOC: 50' S. & 1670' E. FROM N.W. COR. LOT 24, SEC. 10

FINAL PROOF SURVEY
UNDER

Application No. 48942 Permit No. 36648
IN NAME OF

CHRISTINE L. BUSSARD

Surveyed SEPT. 20, 1923, by R. MUCKEN